


CERTIFIED RECORD OF LAND CORNER MONUMENTATION

History of original corner establishment:

This corner was originally established by Horace G. Pearson, U.S Deputy Mineral Surveyor, in December, 1909, as part of Mineral Survey No. 727. The original notes state that at the corner a 4' long by 6" square pine post was set 18" in the ground from which:

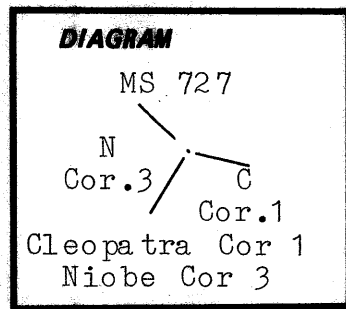

- A 14" fir bears S11°10'W-20.9'.
- A 34" fir bears S59°30'E-33.9'.
- Both marked N.C. 3-1-727 BT.

Description of corner evidence found:

Rotted remains of post at ground level from which:

- A 30" dying white fir bears S11¼°W-21.5' with healed blaze.
- A 36" white fir stump and snag bears S56½°E-35.1' with scribing visible on a partly healed blaze.
- A 1¼" unflanged steel pipe with 2½" aluminum cap by Hambleton bears S62°W-7.3'. This monument was reported by Hambleton to have been set from existing bearing trees - yet the bearing tree tag he placed on the SW bearing tree states the distance to the corner as S08°W-17' (record S11°10'W-20.9'). The monument by Hambleton was set in 1967.

Description of monument and accessories established to perpetuate the original location of this corner:


Set a 2½" by 30" aluminum pipe with 2½" aluminum cap 24" in the ground and surrounded with a mound of earth and stone from which:

- A 12" pon. pine bears N66½°E-41.7' scribed 3-N-1-C-727 BT.
- A 11" douglas fir bears N40¼°W-38.2' scribed 3-N-1-C-727 BT.

New bearing trees have a brass washer stamped PLS 1106 nailed to face of blaze. Attached sign 54-3 and 54-9 and painted face of blaze and a 6" red band around each bearing tree. Set steel fence posts on National Forest Boundary NW and SE of corner and attached sign 54-9 to one post and sign 54-2 to both posts.

Used steel tape and staff compass with 20°E declination, measured to the center of the bearing trees.

Cap is marked:

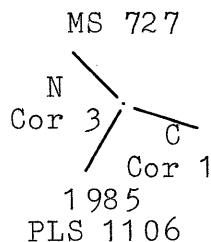

This corner was remonumented on October 10, 1985.

Witness: Willard Hulick.

**REGISTERED
PROFESSIONAL
LAND SURVEYOR**

William R. Wells

**OREGON
JULY 22, 1977
WILLIAM R. WELLS
1106**

Office of County Surveyor County of Baker
Oregon
 State of Oregon, I hereby certify that the within instrument was filed in this office
 for record on the day of , 19
 by (DEPUTY)
 (COUNTY OFFICIAL)