


CERTIFIED RECORD OF LAND CORNER MONUMENTATION

History of original corner establishment:

This corner was originally established by Horace G. Pearson, U.S Mineral Surveyor, as part of Mineral Survey No. 727, during December, 1909. The original notes state that at the corner a 4' long by 6" square marked pine post was set 18" in the ground from which:

- A 8" fir bears N4°W-4.9'.
- A 8" fir bears N65°E-10.3'.
- Both marked C-4-727 BT.

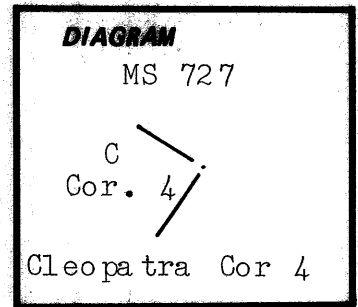

In 1967, Jim Hambleton found the wood post monument and bearing trees and remonumented the corner.

Description of corner evidence found:

Hambleton's 1 1/4" unflanged steel pipe with 2 1/2" aluminum cap, protruding 15" from the ground from which:

A 15" white fir bears N14°W-5.1' with scribing visible on a previously opened blaze.

Also found rotted remains of the original post at ground level and the squared off original post lying beside Hambleton's monument.

Description of monument and accessories established to perpetuate the original location of this corner:

Set a 2 1/2" by 30" aluminum pipe with 2 1/2" aluminum cap 24" in the ground and surrounded with a mound of earth and stone. Buried Hambleton's monument horizontally next to the new monument. Placed original wood post on the new mound. From the monument:


A 13" white fir bears S74 1/2°E-13.2' scribed 4-C-727 BT.

New bearing tree has a brass washer stamped PLS 1106 nailed to the face of blaze. Attached sign 54-3 and 54-9 and painted face of blaze and a 6" red band around each bearing tree. Set steel fence posts NW and SW of corner and attached sign 54-9 to one post and sign 54-2 to both posts.

Used steel tape and staff compass with 20°E declination, measured to the center of the bearing trees.

Cap is marked:

MS 727

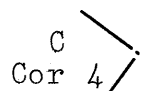

1985
PLS 1106

This corner was remonumented on October 14, 1985.

Witness: Willard Hulick.

**REGISTERED
PROFESSIONAL
LAND SURVEYOR**

Willard R. Wells

**OREGON
JULY 22, 1977
WILLIAM R. WELLS
1106**

Office of County Surveyor County of Baker

State of Oregon, I hereby certify that the within instrument was filed in this office

for record on the..... day of....., 19.....

..... by

(COUNTY OFFICIAL)

(DEPUTY)