


CERTIFIED RECORD OF LAND CORNER MONUMENTATION

History of original corner establishment:

This corner was originally established by Charles M. Foster under Mineral Survey No. 332, during December, 1896. The original notes state that at the corner a 4 1/2' long by 4" square marked pine post was set 18" in the ground and surrounded with a mound of earth from which:

- A 12" tamarack bears S71°W-11 ft.
- A 9" tamarack bears S50 1/2°W-14 ft.
- Both marked 3-332 BT.

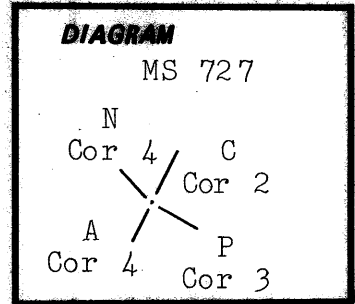

In 1909, during Mineral Survey No. 727, Horace G. Pearson, U.S. Mineral Surveyor, recovered a 4 1/2" square pine post, 3 1/2' above ground, and marked it N.C. 4-2-727, from which:

- A 9" tamarack bears N81°22'W-14.1'.
- A 11" tamarack bears N65°47'W-10.9'.
- Both marked N.C. 4-2-727 BT.

- MS 332
- Niobe Cor 4
- Cleopatra Cor 2
- Pacific Cor 3
- Atlantic Cor 4

Description of corner evidence found:

Found rotted remains of a wood post at ground level and a 3 1/2' section of wood post above ground with visible scribing, from which:

- A 10" western larch stump bears N81 1/2°W-14.7' with fragmentary scribing.
- A 12" western larch bears N66°W-11.4' with no remaining scribing.

See attached narrative regarding difference in bearings between Foster and Pearson surveys.

Description of monument and accessories established to perpetuate the original location of this corner:


Set a 2 1/2" by 30" aluminum pipe with 2 1/2" aluminum cap 24" in the ground and surrounded with a mound of earth. Placed the wood post on the new mound. From the corner:

- A 7" western larch bears N70 1/2°E-31.1' scribed 4-N-2-C-727-4-A-3-P-332 BT.
- A 16" white fir bears N36 1/2°W-45.1' scribed 4-N-2-C-727-4-A-3-P-332 BT.

New bearing trees have a brass washer stamped PLS 1106 nailed to the face of the blaze. Attached sign 54-3 and 54-9 and painted face of blaze and a 6" red band around each bearing tree. Set steel fence post on claim line near corner and attached sign 54-9.

Cap is marked:

Used steel tape and staff compass with 20°E declination, measured to the center of the bearing trees.

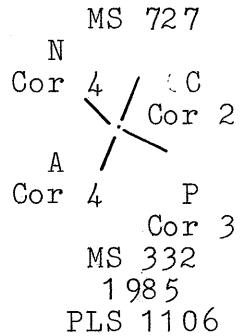

This corner was remonumented on October 10, 1985.

Witness: Willard Hulick.

**REGISTERED
PROFESSIONAL
LAND SURVEYOR**

Willard R. Wells

**OREGON
JULY 22, 1977
WILLIAM R. WELLS
1106**

Office of County Surveyor..... County of Baker.....
State of Oregon....., I hereby certify that the within instrument was filed in this office
for record on the..... day of....., 19.....

(COUNTY OFFICIAL)

(DEPUTY)