


CERTIFIED RECORD OF LAND CORNER MONUMENTATION

History of original corner establishment:

This corner was originally established by Horace G. Pearson, U.S Mineral Surveyor, under Mineral Survey No. 508, during November, 1902. The original notes state that at the corner a 4½' long by 5" square marked pine post was set 18" in the ground from which:

- A 24" pine bears S73°E-22'.
- A 18" pine bears N39°30'E-18'.
- Each marked I.3-508. B.T..

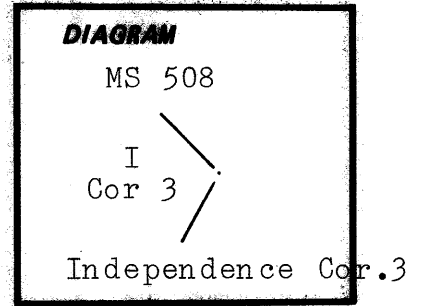

Description of corner evidence found:

Rotted remains of post at ground level from which:

- A 21" down Pon. pine bears N39½°E-18.9' with partly healed blaze and visible scribing.
- A rotted pine stump bears S73°E-22'±.

Hambleton's 1¼" unflanged iron pipe monument with 2½" aluminum cap bears N39½°E-10.1'. Hambleton apparently set his monument 8.0' instead of the record 18.0' from the NE bearing tree.

Description of monument and accessories established to perpetuate the original location of this corner:

Set a 2½" by 30" aluminum pipe with 2½" aluminum cap 24" in the ground and surrounded with a mound of earth and stone from which:


- A 17" doug. fir bears N40½°W-10.6' scribed 3-I-508 BT.
- A 10" white fir bears S83½°E-10.1' scribed 3-I-508 BT.

New bearing trees have a brass washer stamped PLS 1106 nailed to the face of blaze. Attached sign 54-3 and 54-9 and painted face of blaze and a 6" red band around each bearing tree. Set steel fence posts on National Forest Boundary SW and NW of corner and attached sign 54-9 to one post and sign 54-2 to both posts.

Used steel tape with staff compass with 20°E declination, mesured to the center of the bearing trees.

Cap is Marked:

MS 508

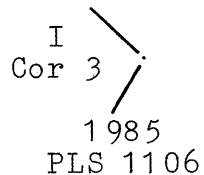

This corner was remonumented on October 11, 1985.

Witness: Willard Hulick.

**REGISTERED
PROFESSIONAL
LAND SURVEYOR**

William R. Wells

**OREGON
JULY 22, 1977
WILLIAM R. WELLS
1106**

Office of County Surveyor County of Baker
Oregon
 State of....., I hereby certify that the within instrument was filed in this office
 for record on the..... day of....., 19.....
 by.....
 (COUNTY OFFICIAL) (DEPUTY)

FILED 2-3-86
 BAKER COUNTY SURVEYOR
 SURVEY NO. 10-35½-142