


**CERTIFIED RECORD OF LAND CORNER MONUMENTATION**

**History of original corner establishment:**

This corner was originally established by Horace G. Pearson, U.S Mineral Surveyor, as part of MS 508, during November, 1902. The original notes state that at the corner a 5' long by 4" square marked fir post was set 18" in the ground from which:

- A 8" fir bears N36°W-13.5'.
- A 8" fir bears N20°30'E-16'.
- Each marked C.P. 5-508 BT.

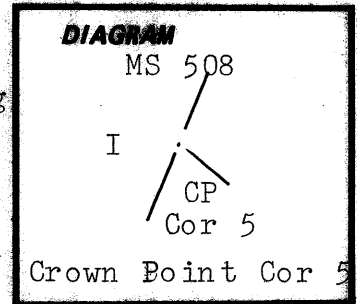

**Description of corner evidence found:**

Mound of stones with rotted remains of post at ground level from which:

A 10" uprooted doug. fir bears N36°W-14'± to root hole with fragmentary scribing visible on open blaze.

Hambleton's 1 1/4" unflanged iron pipe monument with 2 1/2" aluminum cap bears S41 1/2°E-4.9'.

**Description of monument and accessories established to perpetuate the original location of this corner:**

Set a 2 1/2" by 30" aluminum pipe with 2 1/2" aluminum cap 24" in the ground and surrounded with a mound of earth and stone from which:

- A 15" white fir bears N76 1/2°E-19.1' scribed 5-CP-508 BT.
- A 14" white fir bears S23°E-9.5' scribed 5-CP-508 BT.


New bearing trees have a brass washer stamped PLS 1106 nailed to the face of blaze. Attached sign 54-3 and 54-9 and painted face of blaze and a 6" red band around each bearing tree. Set steel fence posts on National Forest Boundary NE and SE of corner and attached sign 54-9 to one post and sign 54-2 to both posts.

Used steel tape and staff compass with 20°E declination. Measured to the center of the bearing trees.

This corner was remonumented on October 11, 1985.

Witness: Willard Hulick.

Cap is marked:

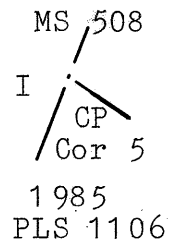

**REGISTERED  
PROFESSIONAL  
LAND SURVEYOR**

*William R. Wells*

**OREGON  
JULY 22, 1977  
WILLIAM R. WELLS  
1106**

Office of County Surveyor County of Baker  
Oregon  
 State of Oregon, I hereby certify that the within instrument was filed in this office  
 for record on the            day of           , 19        
 by            (COUNTY OFFICIAL)            (DEPUTY)

FILED 2-3-86  
 BAKER COUNTY SURVEYOR  
 SURVEY NO. 10-35 1/2 -143