


CERTIFIED RECORD OF LAND CORNER MONUMENTATION

History of original corner establishment:

This corner was originally established by Horace G. Pearson, U.S. Mineral Surveyor, as part of Mineral Survey No. 508, during November, 1902. The original notes state that at the corner a 4½' long by 6" square marked tamarack post was set 18" in the ground from which:

- A 20" pine bears South 7.5'.
- A 12" pine bears S87°30'W-15.3'.
- Each marked I.-4-508 and C.P.-6-508 BT.

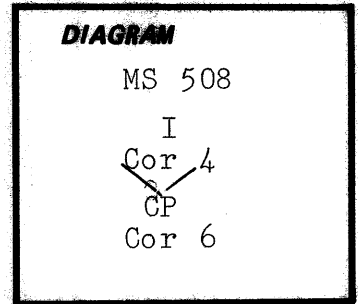

Independence Cor 4
Crown Point Cor 6

Description of corner evidence found:

Rotted remains of post at ground level from which:

- A 15" uprooted pon. pine stump bears South - 8'± with no remaining scribing.
- A rotten pon. pine stump bears S86½°W-15.8' with part of blaze lying downhill from stump.

Description of monument and accessories established to perpetuate the original location of this corner:

Set a 2½" by 30" aluminum pipe with 2½" aluminum cap 26" in the ground and surrounded with a mound of earth and stone from which:

- A 10" western larch bears N76½°E-31.8' scribed 4-I-6-CP-508 BT.
- A 9" white fir bears S51½°E-26.4' scribed 4-I-6-CP-508 BT.

New bearing trees have a brass washer stamped PLS 1106 nailed to the face of blaze. Attached sign 54-3 and 54-9 and painted face of blaze and a 6" red band around each bearing tree. Set steel fence post on claim line near corner and attached sign 54-9.

Used steel tape with staff compass with 20°E declination, measured to the center of the bearing trees.

Cap is marked:

MS 508
I
Cor 4
CP
Cor 6
1985
PLS 1106

This corner was remonumented on October 11, 1985.

Witness: Willard Hulick.

**REGISTERED
PROFESSIONAL
LAND SURVEYOR**

Willard R. Wells

**OREGON
JULY 22, 1977
WILLIAM R. WELLS
1106**

Office of County Surveyor County of Baker
Oregon
 State of Oregon, I hereby certify that the within instrument was filed in this office
 for record on the day of , 19
 by (DEPUTY)
 (COUNTY OFFICIAL)

FILED 2-3-86
 BAKER COUNTY SURVEYOR
 SURVEY NO. 10-35½-144