


**CERTIFIED RECORD OF LAND CORNER MONUMENTATION**

**History of original corner establishment:**

This corner was originally established by Horace G. Pearson, U.S. Mineral Surveyor, as part of Mineral Survey No. 727, during December, 1909. The original notes state that at the corner a 4' long by 4" square marked fir post was set 18" in the ground and surrounded with a mound of earth from which:

A 17" fir bears S70°55'W-18.7', scribed C-3-727 BT.

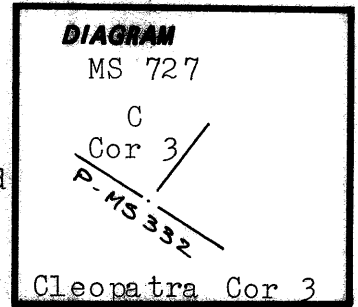

This corner was remonumented by James Hambleton in 1967.

**Description of corner evidence found:**

Hambleton's 1 1/4" unflanged iron pipe with 2 1/2" aluminum cap protruding 15" from a small stone mound from which:

A 29" douglas fir bears S70°W-19.4' with healed blaze.

Found traces of the original wood post when digging in the new monument.

Hambleton's monument is 30" long.

**Description of monument and accessories established to perpetuate the original location of this corner:**

Set a 2 1/2" by 30" aluminum pipe with 2 1/2" aluminum cap 10" in the ground to rock and surrounded with a mound of earth and stone. Buried Hambleton's monument horizontally in the new mound. From the new monument:

A 17" douglas fir bears S10 1/2°W-41.7' scribed 3-C-727 BT.

New bearing tree has a brass washer stamped PLS 1106 nailed to the face of blaze. Attached sign 54-3 and 54-9 and painted face of blaze and a 6" red band around each bearing tree. Set steel fence posts on National Forest Boundary NE and SE of corner and attached sign 54-9 to one post and sign 54-2 to both posts.

Used steel tape and staff compass with 20°E declination, measured to the center of the bearing trees.

This corner was remonumented on October 14, 1985.

Witness: Willard Hulick.


**REGISTERED  
PROFESSIONAL  
LAND SURVEYOR**

*William R. Wells*

**OREGON  
JULY 22, 1977  
WILLIAM R. WELLS  
1106**

Cap is marked:

MS 727

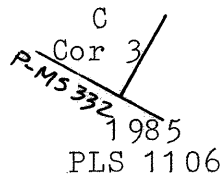

Office of County Surveyor County of Baker  
State of Oregon, I hereby certify that the within instrument was filed in this office  
for record on the..... day of....., 19.....  
..... by .....

(COUNTY OFFICIAL)

(DEPUTY)

FILED 2-3-86  
BAKER COUNTY SURVEYOR  
SURVEY NO. 10-35E-145