


**CERTIFIED RECORD OF LAND CORNER MONUMENTATION**

**History of original corner establishment:**

This corner was originally established by Horace G. Pearson, U.S. Deputy Mineral Surveyor, as part of Mineral Survey No. 509 Amended, during March, 1903. The original notes state that at the corner a 4½' long by 4" square marked fir post was set 18" in the ground from which:

- A 10" fir bears S76°30'W-9.1'.
- A 24" fir bears N2°30'W-23.1'.
- Each marked J.P. 2-509 B.T.

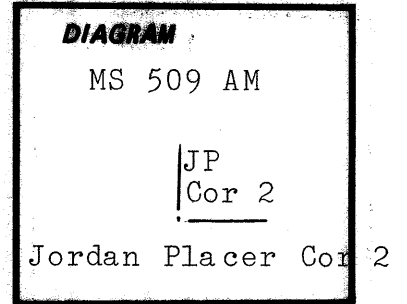

In 1967, this corner was remonumented by Leland Myers.

**Description of corner evidence found:**

A 30" englemann spruce bears N2½°W-23.0' to where face of blaze would be and 24.2' to centerline. This bearing tree is dead and down. Scribing is visible on an open blaze.

The corner was reestablished by measuring record bearing and distance to where the face of blaze would be.

Myers' monument was not found-- there has been logging and roadbuilding activity in the area and his monument must have been destroyed.

**Description of monument and accessories established to perpetuate the original location of this corner:**

Set a 2½" by 30" aluminum pipe with 2½" aluminum cap 15" in the ground to rock and surrounded with a mound of earth and stone from which:

- A 14" englemann spruce bears S233/4°E-32.3' scribed 2-JP-509AM BT. This tree is also a claim corner for the NW corner of the K-Whopper Placer Claim.
- A 13" white fir bears S62½°W-35.2' scribed 2-JP-509AM BT.

New bearing trees have a brass washer stamped PLS 1106 nailed to the face of blaze. Attached sign 54-3 and 54-9 and painted face of blaze and a 6" red band around each bearing tree. Set steel fence post East of corner and attached sign 54-9.

Used steel tape and staff compass with 20°E declination, measured to the center of the bearing trees.

Cap is marked:

MS 509 AM

JP  
Cor 2  
1985  
PLS 1106

This corner was remonumented on October 16, 1985.

Witness: Willard Hulick.

REGISTERED  
PROFESSIONAL  
LAND SURVEYOR

*William R. Wells*

OREGON  
JULY 22, 1977  
WILLIAM R. WELLS  
1106

Office of County Surveyor ..... County of Baker  
State of Oregon ..... I hereby certify that the within instrument was filed in this office  
for record on the ..... day of ..... 19.....  
..... by .....  
(COUNTY OFFICIAL) (DEPUTY)

FILED 2-3-85  
BAKER COUNTY SURVEYOR  
SURVEY NO. 10-35½-146