


CERTIFIED RECORD OF LAND CORNER MONUMENTATION

History of original corner establishment:

This corner was originally established by Horace G. Pearson, U.S. Deputy Mineral Surveyor, as part of MS 509 Amended, during March, 1903. The original notes state that at the corner a 4½' long by 4" square marked tamarack post was set 18" in the ground from which:

- A 16" fir bears S21°30'W-25.1'.
- A 30" fir bears S81°W-28.5'.
- Each marked D.G.P. 3-509 BT.

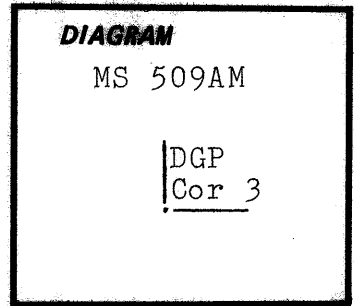

Deep Gravel Placer Cor 3

This corner was remonumented by Leland Myers in 1967.

Description of corner evidence found:

Myers' 5/8" by 24" iron pin with 1½" aluminum cap protruding 4" from a mound of stone. Found remains of original post when digging in new monument. From the monument:

- A 45" white fir bears S84°W-29.2' with healed blaze.
- A 24" dead, white fir snag bears S23½°W-25.5' with scribing visible on a partly healed blaze.

Description of monument and accessories | established to perpetuate the original location of this corner:

Set a 2½" by 30" aluminum pipe with 2½" aluminum cap 22" in the ground and surrounded with a mound of earth and stone. Placed Myers' monument inside our new monument and placed original post remains on the new mound. From the new monument:

A 11" white fir bears S40½°E-37.5' scribed 3-DGP-509AM BT. New bearing tree has a brass washer stamped PLS 1106 nailed to the face of blaze. Attached sign 54-3 and 54-9 and painted face of blaze and a 6" red band around each bearing tree. Set steel fence posts on National Forest Boundary North and East of corner and attached sign 54-9 to one post and sign 54-2 to both posts.

Used steel tape and staff compass with 20°E declination, measured to the center of the bearing trees.

Cap is marked:
MS 509AM

| DGP
| Cor 3

1985
PLS 1106

This corner was remonumented on October 17, 1985.

Witness: Willard Hulick.

**REGISTERED
PROFESSIONAL
LAND SURVEYOR**

William R. Wells

**OREGON
JULY 22, 1977
WILLIAM R. WELLS
1106**

Office of County Surveyor County of Baker
 State of Oregon I hereby certify that the within instrument was filed in this office
 for record on the day of , 19.....
 by
 (COUNTY OFFICIAL) (DEPUTY)

FILED 2-3-86
BAKER COUNTY SURVEYOR
SURVEY NO. 10-35E-147