


CERTIFIED RECORD OF LAND CORNER MONUMENTATION

History of original corner establishment:

This corner was originally established by Horace G. Pearson, U.S. Deputy Mineral Surveyor, as part of Mineral Survey No. 508, during November, 1902. The original notes state that at the corner a 4½' long by 4" square marked pine post was set 18" in the ground from which:

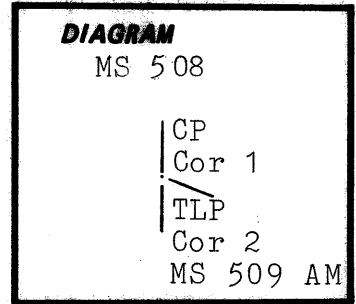

A 24" fir bears S67°30'W-21.5'.
A 30" pine bears S45°W-41.1'.

Each marked C.P. 1-508 B.T. and T.L.P. 2-509 B.T.. Crown Point Cor 1 MS 508
Too Late Placer Cor 2 MS 509AM

During March of 1903, Horace G. Pearson also established this corner as Corner 2 of the Too Late Placer of MS 509 Amended. Bearing trees are same as the MS 508 Survey.

Description of corner evidence found:

Rotted remains of post at ground level from which:

A 36" pon. pine stump bears S47°W-42.1' with no remaining scribing.
A 30" rotted fir stump bears S69½°W-22.3' with no remaining scribing.

Description of monument and accessories | established to perpetuate the original location of this corner:

Set a 2½" by 30" aluminum pipe with 2½" aluminum cap 24" in the ground and surrounded with a mound of earth and stone. Placed original post remains on the new mound. From the new monument:

A 13" douglas fir bears N55½°W-35.6' scribed 1-CP-508-2-TLP-509AM BT.
A 11" pon. pine bears N28½°E-53.8' scribed 1-CP-508-2-TLP-509AM BT.

New bearing trees have a brass washer stamped PLS 1106 nailed to the face of blaze. Attached sign 54-3 and 54-9 and painted face of blaze and a 6" red band around each bearing tree. Set steel fence post on claim line North of corner and attached sign 54-9.

Used steel tape and staff compass with 20°E declination, measured to the center of the bearing trees.

Cap is marked:

MS 508
| CP
| Cor 1
| TLP
| Cor 2
MS 509AM
1985
PLS 1106

This corner was remonumented on October 16, 1985.

Witness: Willard Hulick.

**REGISTERED
PROFESSIONAL
LAND SURVEYOR**

William R. Wells

**OREGON
JULY 22, 1977
WILLIAM R. WELLS
1106**

Office of County Surveyor..... County of Baker.....
Oregon
State of....., I hereby certify that the within instrument was filed in this office
for record on the..... day of....., 19.....
..... by

(COUNTY OFFICIAL)

(DEPUTY)

FILED 2-3-86
BAKER COUNTY SURVEYOR
SURVEY NO. 10-352-148