


CERTIFIED RECORD OF LAND CORNER MONUMENTATION

History of original corner establishment:

This corner was originally established by Horace G. Pearson, U.S. Deputy Mineral Surveyor, as part of MS 509 Amended, during March, 1903. The original notes state that at the corner a 4 1/2' long by 4" square marked pine post was set 18" in the ground from which

A 10" fir bears S83°E-35.8'.
A 30" pine bears N51°30'E-27.9'.
Each marked T.L.P. 3-509 BT.

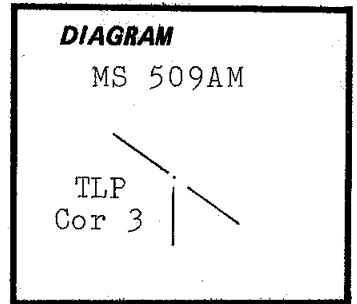

Too Late Placer Cor 3

Description of corner evidence found:

Rotted remains of post at ground level from which:

A 28" pon. pine ^{STUMP} bears N52°E-29.0' with no remaining scribing.
A rotted fir bears S83°E-36'±.

Ground

Description of monument and accessories established to perpetuate the original location of this corner:

Set a 2 1/2" by 30" aluminum pipe with 2 1/2" aluminum cap 24" in the ground and surrounded with a mound of earth and stone. Placed original post remains on the new mound. From the new monument:

A 10" white fir bears N28 1/2°E-30.0' scribed 3-TLP-509AM BT.
A 6" white fir bears S88°E-5.9' scribed 3-TLP-509AM BT.

Each new bearing tree has a brass washer stamped PLS 1106 nailed to the face of blaze. Attached sign 54-3 and 54-9 and painted face of blaze and a 6" red band around each bearing tree. Set steel fence posts on National Forest Boundary South and SE of corner and attached sign 54-9 to one post and sign 54-2 to both posts.

Used steel tape and staff compass with 20°E declination, measured to the center of the bearing trees.

Cap is Marked:

MS 509 AM

This corner was remonumented on October 17, 1985.

Witness: Willard Hulick.

REGISTERED
PROFESSIONAL
LAND SURVEYOR

William R. Wells

OREGON
JULY 22, 1977
WILLIAM R. WELLS
1106

TLP
Cor 3
MS 509AM
1985
PLS 1106
C.P. MS 508

Office of... County Surveyor County of... Baker

State of... Oregon....., I hereby certify that the within instrument was filed in this office for record on the..... day of....., 19.....

..... by
(COUNTY OFFICIAL) (DEPUTY)

FILED 2-3-86

BAKER COUNTY SURVEYOR

SURVEY NO. 10-352-152