


**CERTIFIED RECORD OF LAND CORNER MONUMENTATION**

**History of original corner establishment:**

This corner was originally established as Haggard Quartz Claim Corner 1, under MS 266A, by Charles M. Foster, in November, 1892. The original notes state that at the corner a marked post was set, from which:

- A 2' Fir bears S 76° W - 45', marked: H Qtz. C. Cor 1 BT.
- A 20" Pine bears N 18½° W - 15', marked: H Qtz. C. Cor 1 BT.

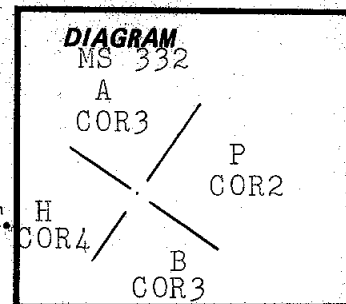

- Atlantic Cor. 3
- Pacific Cor. 2
- Haggard Cor. 4
- Bonanza Cor. 3

In December 1896, under MS 332, Charles Foster recovered the corner and established it as Bonanza Cor. 3, Haggard Cor. 2, Pacific Cor. 2, and Atlantic Cor. 3. The original notes state that at the corner a 4½' long by 4" square marked post was set 18" in the ground with a mound of earth, from which:

**Description of corner evidence found:**

Found large mound of earth and original wood post rotted off at ground level, and leaning against a tree stump. Also found more recent sawed square post. Found rotted remains of original post below ground, from which:

- A root hole bears S 76° W - 45' ±.

**REGISTERED PROFESSIONAL LAND SURVEYOR**

*Willi R. Wells*

**OREGON  
JULY 22, 1977  
WILLIAM R. WELLS  
1106**

**Description of monument and accessories established to perpetuate the original location of this corner:**

Set a 2½" by 30" aluminum pipe with 2½" aluminum cap, 24" in the ground and surrounded with a mound of earth and stones. Placed found posts on the mound. From the new monument:

- A 8" White Fir bears S 5° E - 32.6', scribed: 3-B-2-P-3-A-4-H-332 BT.
- A 10" White Fir bears N 72½° W - 29.0', scribed: 3-B-2-P-3-A-4-H-332 BT.

New bearing trees have a brass washer stamped PLS 1106 nailed to face of blaze. Attached signs 54-3 and 54-9, and painted face of blaze and a 6" red band around each bearing tree.


Set steel fence post on claim line Northeast of corner, and attached sign 54-9.

Used steel tape and staff compass with 20°E declination, measured to the center of the bearing trees.

This corner was remonumented on October 10, 1985.

Witnessed by: Willard Hulick.

Cap is marked:  
MS 332

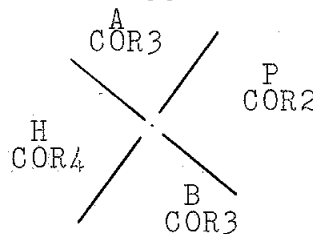

Office of.....County Surveyor..... County of.....Baker..... PLS 1106  
State of.....Oregon....., I hereby certify that the within instrument was filed in this office  
for record on the..... day of....., 19.....

..... by .....  
(COUNTY OFFICIAL) (DEPUTY)

FILED 7-21-86  
BAKER COUNTY SURVEYOR  
SURVEY NO. 10-35½-158