


CERTIFIED RECORD OF LAND CORNER MONUMENTATION

History of original corner establishment:

A 20" Pine bears N 18½° W - 15', marked: 3-332 BT.  
A 2' Fir bears S 76° W - 45', marked: 3-332 BT.

See narrative recorded in Baker County Surveyors Office, regarding monumentation.

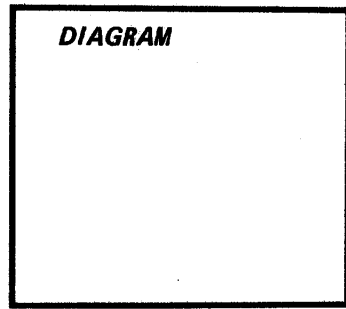

Atlantic Cor. 3  
Pacific Cor. 2  
Haggard Cor. 4  
Bonanza Cor. 3

Description of corner evidence found:

REGISTERED  
PROFESSIONAL  
LAND SURVEYOR

*William R. Wells*

OREGON  
JULY 22, 1977  
WILLIAM R. WELLS  
1106

Description of monument and accessories I established to perpetuate the original location of this corner:

Office of.....County Surveyor..... County of.....Baker.....  
State of.....Oregon....., I hereby certify that the within instrument was filed in this office  
for record on the..... day of....., 19.....  
..... by .....  
(COUNTY OFFICIAL) (DEPUTY)

FILED 7-21-86  
BAKER COUNTY SURVEYOR  
SURVEY NO. 10-35 1/2-158