


**CERTIFIED RECORD OF LAND CORNER MONUMENTATION**

**History of original corner establishment:**

This corner was originally established as Corner 1 of the Independence Lode, and Corner 1 of the Richmond Lode, under MS 508, by Horace G. Pearson, U. S. Deputy Mineral Surveyor, during November 1902. The original notes state that a 4½' long by 4" square pine post was set 18" in the ground with mound of earth, marked: R 1-508 and I 1-508.

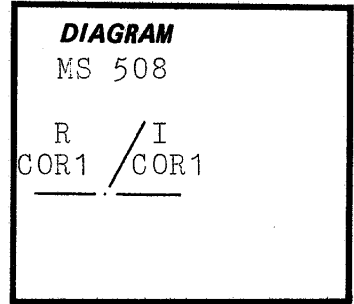

Independence Cor. 1  
Richmond Cor. 1

**Description of corner evidence found:**

Found rotted remains of post below ground level after surveying into area from adjacent corners. Placed rotted post remains on mound.

**REGISTERED  
PROFESSIONAL  
LAND SURVEYOR**

*William R. Wells*

**OREGON  
JULY 22, 1977  
WILLIAM R. WELLS  
1106**

**Description of monument and accessories established to perpetuate the original location of this corner:**

Set a 2½" by 30" aluminum pipe with 2½" aluminum cap 22" in the ground and surrounded with a mound of earth and stone, from which:

A 10" White Fir bears S 79° E - 32.5', scribed: 1-I-1-R-508 BT.

A 9" Ponderosa Pine bears S 10½° W - 37.1', scribed: 1-I-1-R-508 BT.

New bearing trees have a brass washer stamped PLS 1106 nailed to face of blaze. Attached signs 54-3 and 54-9, and painted face of blaze and a 6" red band around each bearing tree.

Set steel fence post on claim line Northeast of corner, and attached sign 54-9.

Used steel tape and staff compass with 20°E declination, measured to the center of the bearing trees.

This corner was remonumented on June 4, 1986.

Witnessed by: Willard Hulick.

Cap is marked:

MS 508  
R / I  
COR1 / COR1  
1986  
PLS 1106

Office of..... County Surveyor..... County of..... Baker.....  
State of..... Oregon....., I hereby certify that the within instrument was filed in this office  
for record on the..... day of....., 19.....  
..... by .....

(COUNTY OFFICIAL)

(DEPUTY)

FILED 7-21-1986  
BAKER COUNTY SURVEYOR  
SURVEY NO. 10-35½-159