


CERTIFIED RECORD OF LAND CORNER MONUMENTATION

**History of original corner establishment:**

This corner was originally established as Corner 5 of the Independence Lode, and Corner 7 of the Crown Point Lode, under MS 508, by Horace G. Pearson, U. S. Deputy Mineral Surveyor, during November 1902. The original notes state that a 4' long by 4" square pine post was set 1' in the ground to bedrock with a mound of earth, marked: I5-508 and CP7-508.

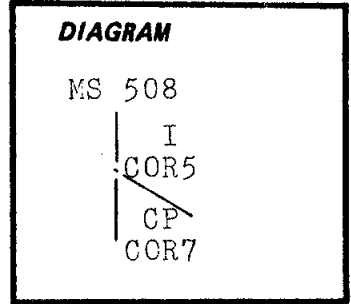

Independence Cor. 5  
Crown Point Cor. 7

**Description of corner evidence found:**

Found a mound of earth and rotted remains of post at ground level.

**REGISTERED  
PROFESSIONAL  
LAND SURVEYOR**

*William R. Wells*

**OREGON  
JULY 22, 1977  
WILLIAM R. WELLS  
1106**

**Description of monument and accessories I established to perpetuate the original location of this corner:**

Set a 2½" by 30" aluminum pipe with 2½" aluminum cap 24" in the ground and surrounded with a mound of earth and stone. Placed post remains on mound. From the new monument:

A 8" White Fir bears N 9½° W - 6.5', scribed: 5-I-7-CP-508 BT.

A 8" White Fir bears S 60° E - 17.1', scribed: 5-I-7-CP-508 BT.

New bearing trees have a brass washer stamped PLS 1106 nailed to face of blaze. Attached signs 54-9 and 54-3, and painted face of blaze and a 6" red band around each bearing tree.

Set steel fence post on claim line and attached sign 54-9.

Used steel tape and staff compass with 20°E declination, measured to the center of the bearing trees.

This corner was remonumented on June 4, 1986.

Witnessed by: Willard Hulick.

Cap is marked:

MS 508  
I  
COR5  
CP  
COR7  
1986  
PLS 1106

Office of.....County Surveyor..... County of..... Baker.....  
State of..... Oregon....., I hereby certify that the within instrument was filed in this office  
for record on the..... day of....., 19.....

..... by .....  
(COUNTY OFFICIAL) (DEPUTY)

FILED 7-21-86  
BAKER COUNTY SURVEYOR  
SURVEY NO. 70-353-181