


CERTIFIED RECORD OF LAND CORNER MONUMENTATION

History of original corner establishment:

The corner was originally established as West End Center, Alaska Lode, under MS 508, by Horace G. Pearson, U. S. Deputy Mineral Surveyor, during November 1902. The original notes state that a 4½' long by 4" square pine post was set 6" in the ground to bedrock with a mound of earth and stone, scribed: A-MS-508.

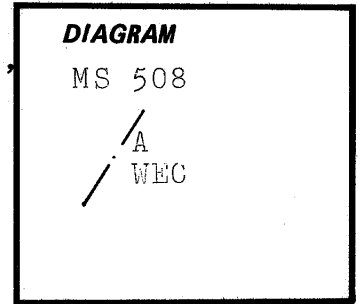

ALASKA WEST END CENTER

Description of corner evidence found:

Found mound of earth and stone and rotted post remains at ground level.

REGISTERED
PROFESSIONAL
LAND SURVEYOR

William R. Wells

OREGON
JULY 22, 1977
WILLIAM R. WELLS
1106

Description of monument and accessories I established to perpetuate the original location of this corner:

Set a 2½" by 30" aluminum pipe with 2½" aluminum cap 12" in the ground to bedrock and surrounded with a mound of earth and stone. Chipped down through 10" of softer rock then hit hard rock. Corner falls on a rock outcropping. From the new monument:

A 6" Ponderosa Pine bears N 2½° E - 32.9', scribed: WEC-A-508 BT.

A 10" Ponderosa Pine bears S 87½° W - 41.4', scribed: WEC-A-508 BT.

New bearing trees have a brass washer stamped PLS 1106 nailed to face of blaze. Attached signs 54-3 and 54-9, and painted face of blaze and a 6" red band around each bearing tree.

Set steel fence posts on National Forest Boundary Northeast and Southwest of corner, and attached sign 54-9 to one post, and sign 54-2 to both posts.

Used steel tape and staff compass with 20° E declination, measured to the center of the bearing trees.

This corner was remonumented on June 4, 1986.

Cap is marked:

Witnessed by: Willard Hulick.

MS 508

/ A
/ WEC

1986

PLS 1106

Office of..... County Surveyor..... County of..... Baker.....
State of..... Oregon....., I hereby certify that the within instrument was filed in this office
for record on the..... day of....., 19.....
..... by
(COUNTY OFFICIAL) (DEPUTY)

FILED 7-21-86
BAKER COUNTY SURVEYOR
SURVEY NO. 10-35 1/2 162