


**CERTIFIED RECORD OF LAND CORNER MONUMENTATION**

**History of original corner establishment:**

The corner was originally established as Corner 4 of the Crown Point Lode, under MS 508, by Horace G. Pearson, U. S. Deputy Mineral Surveyor, during November 1902. The original notes state that a 4½' long by 4" square tamarack post was set 18" in the ground, scribed: CP 4-508, from which:

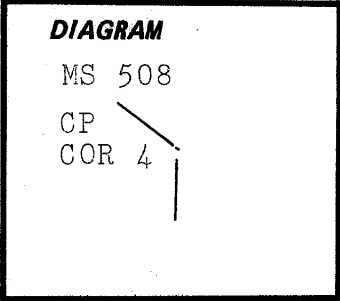

A 8" Fir bears N 49° 30' E. 11.3', blazed and scribed: C.P. 4-508 BT.

A 20" Fir bears N 43° 30' W. 18.5', blazed and scribed: C.P. 4-508 BT.

**Description of corner evidence found:**

The corner has been destroyed by a road. A 2½" aluminum cap on 1¼" unflanged GIP by Hambleton bears S 71° E - 3.6', sticking 18" out of the ground. Re-established corner by survey using compass rule method, after rotating record bearings to observed bearings.

**Description of monument and accessories | established to perpetuate the original location of this corner:**

Set a 2½" by 30" aluminum pipe with 2½" aluminum cap 22" in the ground and surrounded with a mound of earth and stone, from which:

A 12" Douglas Fir bears N 49½° E - 41.4', scribed: 4-CP-508 BT.

A 13" Douglas Fir bears S 44½° E - 58.9', scribed: 4-CP-508 BT.

New bearing trees have a brass washer stamped PLS 1106 nailed to face of blaze. Attached signs 54-3 and 54-9, and painted face of blaze and a 6" red band around each bearing tree.

Set steel fence posts on National Forest Boundary South and Northwest of corner and attached sign 54-9 to one post, and sign 54-2 to both posts.

Used steel tape and staff compass with 20°E declination, measured to the center of the bearing trees.

This corner was remonumented on June 4, 1986.

Witnessed by: Willard Hulick.

**REGISTERED  
PROFESSIONAL  
LAND SURVEYOR**

*Willard R. Wells*

**OREGON  
JULY 22, 1977  
WILLIAM R. WELLS  
1106**

Cap is marked:

MS 508  
CP  
COR 4  
1986  
PLS 1106

Office of..... County Surveyor..... County of..... Baker.....  
State of..... Oregon....., I hereby certify that the within instrument was filed in this office  
for record on the..... day of....., 19.....  
..... by .....  
(COUNTY OFFICIAL) (DEPUTY)

FILED 7-21-86  
BAKER COUNTY SURVEYOR  
SURVEY NO. 10-358-165

165