


**CERTIFIED RECORD OF LAND CORNER MONUMENTATION**

**History of original corner establishment:**

The corner was originally established as Corner 5 of the Alaska Lode, under MS 508, by Horace G. Pearson, U. S. Deputy Mineral Surveyor, during November 1902. The original notes state that a 4½' long by 4" square pine post was set 18" in the ground with mound of earth, scribed: A 5-508.

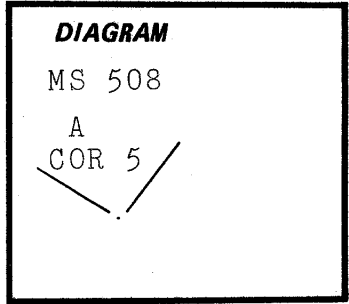

Alaska Cor. 5

**Description of corner evidence found:**

Found rotted remains of original post below ground level after surveying into area.

**Description of monument and accessories I established to perpetuate the original location of this corner:**

Set a 2½" by 30" aluminum pipe with 2½" aluminum cap 24" in the ground and surrounded with a mound of earth and stone, from which:

A 15" Douglas Fir bears N 88° W - 42.7', scribed: 5-A-508 BT.

A 12" White Fir bears N 5½° W - 7.8', scribed: 5-A-508 BT.

New bearing trees have a brass washer stamped PLS 1106 nailed to face of blaze. Attached signs 54-3 and 54-9, and painted face of blaze and a 6" red band around each bearing tree.

Set steel fence post on claim line Northeast of corner, and attached sign 54-9.

Used steel tape and staff compass with 20°E declination, measured to the center of the bearing trees.

This corner was remonumented on June 4, 1986.

Witnessed by: Willard Hulick.

**REGISTERED  
PROFESSIONAL  
LAND SURVEYOR**

*William R. Wells*  
**OREGON  
JULY 22, 1977  
WILLIAM R. WELLS  
1108**

Cap is marked:

MS 508  
A  
COR 5  
1986  
PLS 1106

Office of..... County Surveyor..... County of..... Baker  
State of..... Oregon....., I hereby certify that the within instrument was filed in this office  
for record on the..... day of....., 19.....  
..... by .....  
(COUNTY OFFICIAL) (DEPUTY)

FILED 7-21-86  
BAKER COUNTY SURVEYOR  
SURVEY NO. 10-352-166