


CERTIFIED RECORD OF LAND CORNER MONUMENTATION

History of original corner establishment:

The corner was originally established as Corner 3 of the Protection Lode, under MS 508, by Horace G. Pearson, U. S. Deputy Mineral Surveyor, during November 1902. The original notes state that a 4½' long by 5" square fir post was set 18" in the ground with mound of earth and stone, scribed: P 3-508.

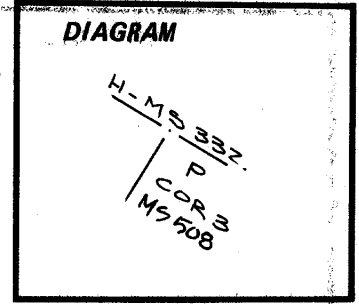

Protection Cor. 3

This corner was remonumented by James Hambleton in 1968.

Description of corner evidence found:

Found a mound of earth and stone with rotted remains of post at ground level. Surveyed to corner before finding it. A monument reportedly set by James Hambleton in 1968 was not found.

Description of monument and accessories I established to perpetuate the original location of this corner:

Set a 2½" by 30" aluminum pipe with 2½" aluminum cap 22" in the ground and surrounded with a mound of earth and stone, from which:

A 10" Ponderosa Pine bears S 5½° W - 14.4', scribed: 3-P-508 BT.

A 9" Ponderosa Pine bears N 51½° W - 9.2', scribed: 3-P-508 BT.

New bearing trees have a brass washer stamped PLS 1106 nailed to face of blaze. Attached signs 54-3 and 54-9, and painted face of blaze and a 6" red band around each bearing tree.

Set steel fence posts on National Forest Boundary Southwest and Northwest of corner and attached sign 54-9 to one post, and sign 54-2 to both posts.

Used steel tape and staff compass with 20°E declination, measured to the center of the bearing trees.

This corner was remonumented on June 4, 1986.

Cap is marked:

Witnessed by: Willard Hulick.

**REGISTERED
PROFESSIONAL
LAND SURVEYOR**

William R. Wells

**OREGON
JULY 22, 1977
WILLIAM R. WELLS
1106**

H-MS 332
P
COR 3
MS 508

1986
PLS 1106

Office of..... County Surveyor..... County of..... Baker.....
State of..... Oregon..... I hereby certify that the within instrument was filed in this office
for record on the..... day of..... 19.....

(COUNTY OFFICIAL)

(DEPUTY)

FILED 7-21-86
BAKER COUNTY SURVEYOR
SURVEY NO. 10-35 1/2-167