


**CERTIFIED RECORD OF LAND CORNER MONUMENTATION**

**History of original corner establishment:**

The corner was originally established as Corner 2 of the Alaska Lode, Corner 1 of the Protection Lode, and Corner 4 of the Richmond Lode, under MS 508, by Horace G. Pearson, U. S. Deputy Mineral Surveyor, during November 1902. The original notes state that a 4½' long by 6" square pine post was set 18" in the ground with mound of earth, marked: A 2-508 and R 4-508 and P 1-508.

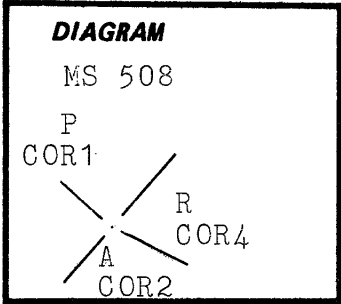

Alaska Cor. 2  
Protection Cor. 1  
Richmond Cor. 4

This corner was supposedly remonumented by James Hambleton in 1968.

**Description of corner evidence found:**

Found mound of earth and stone and rotted remains of post at ground level. Also found rotted original post lying above ground next to mound. Surveyed to corner before finding it.

A down 2½" aluminum cap on 1¼" unflanged GIP, set by Hambleton for the corner bears N 49° 35' E - 27.7'.

**REGISTERED  
PROFESSIONAL  
LAND SURVEYOR**

*William R. Wells*

OREGON  
JULY 22, 1977  
**WILLIAM R. WELLS**  
1106

**Description of monument and accessories | established to perpetuate the original location of this corner:**

Set a 2½" aluminum pipe with 2½" aluminum cap 24" in the ground and surrounded with a mound of earth and stone. Placed remains of original post on mound. From the new monument:

A 6" Ponderosa Pine bears S 84½° E - 23.1', scribed: 2-A-1-P-4-R-508 BT.

A 9" Douglas Fir bears N 2½° E - 41.8', scribed: 2-A-1-P-4-R-508 BT.

New bearing trees have a brass washer stamped PLS 1106 nailed to face of blaze. Attached signs 54-3 and 54-9, and painted face of blaze and a 6" red band around each bearing tree.


Set steel fence posts on National Forest Boundary Northwest and Southwest of corner, and attached sign 54-9 to one post, and sign 54-2 to both posts.

Used steel tape and staff compass with 20°E declination, measured to the center of the bearing trees.

This corner was remonumented on June 4, 1986.

Cap is marked:  
MS 508

Witnessed by: Willard Hulick.

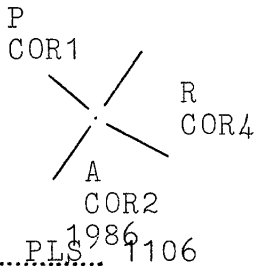

Office of..... County Surveyor..... Baker  
Oregon..... County of.....  
State of..... I hereby certify that the within instrument was filed in this office  
for record on the..... day of....., 19.....  
..... by.....  
(COUNTY OFFICIAL) (DEPUTY)

FILED 7-21-86  
BAKER COUNTY SURVEYOR  
SURVEY NO. 10-35 1/2 108