


CERTIFIED RECORD OF LAND CORNER MONUMENTATION

**History of original corner establishment:**

None. Corner had not been established.

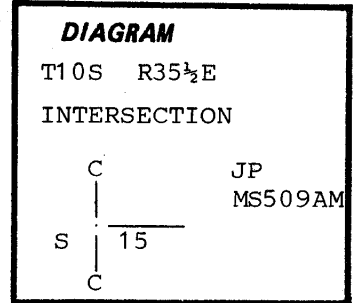

No evidence of corner establishment found in County Records.

**Description of corner evidence found:**

None. Corner established by survey.

**Description of monument and accessories established to perpetuate the original location of this corner:**

Set a 2½" by 30" aluminum pipe with 2½" aluminum cap 24" in the ground and surrounded with a mound of earth and stone, from which:

A 8" White Fir bears S 16½° W - 44.5', scribed: INT. C-C S15-JP-509AM BT.

A 13" White Fir bears S 13° E - 46.1', scribed: INT. C-C S15-JP-509AM BT.

New bearing trees have a brass washer stamped PLS 1106 nailed to face of blaze. Attached signs 54-3 and 54-9, and painted face of blaze and a 6" red band around each bearing tree.

Set steel fence posts on National Forest Boundary East and South of corner, and attached sign 54-9 to one post and sign 54-2 to both posts.

Used steel tape and staff compass with 19°E declination, measured to the center of the bearing trees.

This corner was monumented on June 30, 1986.


Witnessed by: Willard Hulick.

**REGISTERED  
PROFESSIONAL  
LAND SURVEYOR**

*William R. Wells*

**OREGON  
JULY 22, 1977  
WILLIAM R. WELLS  
1106**

Cap is marked:

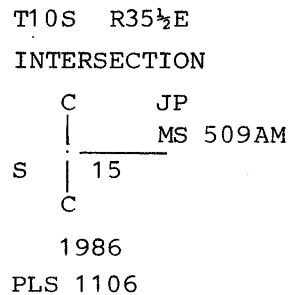

Office of.....County Surveyor..... County of.....Baker.....  
State of.....Oregon....., I hereby certify that the within instrument was filed in this office  
for record on the..... day of....., 19.....  
..... by .....  
(COUNTY OFFICIAL) (DEPUTY)

FILED \_\_\_\_\_  
BAKER COUNTY SURVEYOR  
SURVEY NO. 10-35½-170