


**CERTIFIED RECORD OF LAND CORNER MONUMENTATION**

**History of original corner establishment:**

None. Corner never set.

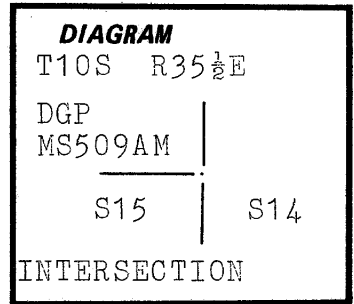

No evidence of corner establishment found in County Records.

**Description of corner evidence found:**

None.

**Description of monument and accessories established to perpetuate the original location of this corner:**

Set a 2½" by 30" aluminum pipe with 2½" aluminum cap 20" in the ground to bedrock and surrounded with a mound of earth and stone, from which:

A 13" Ponderosa Pine bears S 21½° E - 23.3', scribed: INT-DGP-509AM-S14 BT.

A 7" Ponderosa Pine bears S 12° W - 3.7', scribed: INT-DGP-509AM-S15 BT.

New bearing trees have a brass washer stamped PLS 1106 nailed to face of blaze. Attached signs 54-9 and 54-3, and painted face of blaze and a 6" red band around each bearing tree.

Set steel fence posts on National Forest Boundary West and North of corner and attached sign 54-9 to one post, and sign 54-2 to both posts.

Used steel tape and staff compass with 19°E declination, measured to the center of the bearing trees.

This corner was monumented on July 1, 1986.

Witnessed by: Willard Hulick.

<b>REGISTERED PROFESSIONAL LAND SURVEYOR</b>
--

*William R. Wells*

<b>OREGON JULY 22, 1977 WILLIAM R. WELLS 1106</b>
---

Cap is marked:  
T10S R35½E

DGP	
MS509AM	
S15	S14
1986	
PLS 1106	

Office of..... County Surveyor..... County of..... Baker.....

State of..... Oregon....., I hereby certify that the within instrument was filed in this office for record on the..... day of....., 19.....

..... by .....  
(COUNTY OFFICIAL) (DEPUTY)

FILED 7-21-86  
BAKER COUNTY SURVEYOR  
SURVEY NO. 10-35½-171