


CERTIFIED RECORD OF LAND CORNER MONUMENTATION

History of original corner establishment:

None.

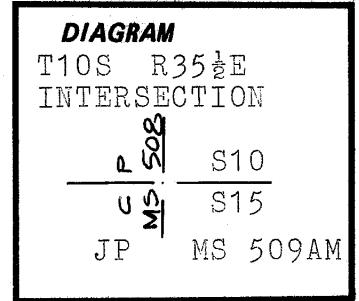

No evidence of corner establishment found in County Records.

Description of corner evidence found:

None.

Description of monument and accessories I established to perpetuate the original location of this corner:

Set a 2½" by 30" aluminum pipe with 2½" aluminum cap 22" in the ground and surrounded with a mound of earth and stone, from which:

A 17" Ponderosa Pine bears N 33½° E - 16.6', scribed: INT-CP-508-S10-S15 BT.

A 11" Ponderosa Pine bears N 74½° E - 24.6', scribed: INT-CP-508-S10-S15 BT.

New bearing trees have a brass washer stamped PLS 1106 nailed to face of blaze. Attached signs 54-3 and 54-9, and painted face of blaze and a 6" red band around each bearing tree.

Set steel fence posts on National Forest Boundary North and East of corner, and attached sign 54-9 to one post, and sign 54-2 to both posts.

Used steel tape and staff compass with 20°E declination, measured to the center of the bearing trees.

This corner was monumented on June 13, 1986.

Witnessed by: Willard Hulick.


**REGISTERED
PROFESSIONAL
LAND SURVEYOR**

William R. Wells

**OREGON
JULY 22, 1977
WILLIAM R. WELLS
1106**

Cap is marked:

T10S R35½E
INTERSECTION

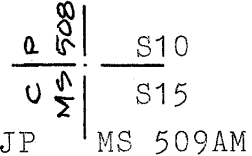

1986
PLS 1106

Office of..... County Surveyor..... County of..... Baker.....

State of..... Oregon....., I hereby certify that the within instrument was filed in this office

for record on the..... day of....., 19.....

..... by
(COUNTY OFFICIAL) (DEPUTY)

FILED 7-21-86
BAKER COUNTY SURVEYOR
SURVEY NO. 10-352-123

173