


CERTIFIED RECORD OF LAND CORNER MONUMENTATION

History of original corner establishment:
History of original corner establishment:

None.

None.

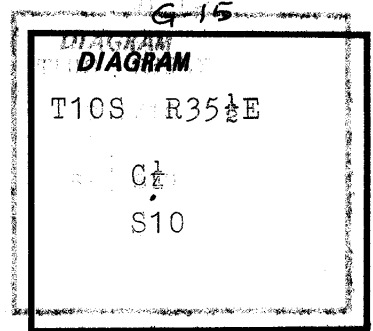

No evidence of corner establishment found in County Records.

Description of corner evidence found:

None.

Description of monument and accessories established to perpetuate the original location of this corner:

Set a 2½" aluminum pipe with 2½" aluminum cap 24" in the ground and surrounded with a mound of earth and stone, from which:

A 16" Ponderosa Pine bears N 12° W - 5.3', scribed: C¼ S10 BT.

A 11" Ponderosa Pine bears S 85½° E - 34.6', scribed: C¼ S10 BT.

Each new bearing tree has a brass washer stamped PLS 1106 nailed to the face of blaze. Attached sign 54-3 and 54-9 and painted face of blaze and a 6" red band around each bearing tree.

Set steel fence post North of corner and attached sign 54-9.

Used steel tape and staff compass with 20° E declination, measured to the center of the bearing trees.

This corner was monumented on June 13, 1986.

Witnessed by: Willard Hulick.

**REGISTERED
PROFESSIONAL
LAND SURVEYOR**

William R. Wells

**OREGON WELLS
JULY 22, 1977
WILLIAM R. WELLS
1106**

Cap is marked:

T10S R35½E

C¼

S10

1986

PLS 1106

Office of..... County Surveyor..... County of..... Baker.....

State of..... Oregon....., I hereby certify that the within instrument was filed in this office

for record on the..... day of....., 19.....

..... by.....

(COUNTY OFFICIAL)

(DEPUTY)