


CERTIFIED RECORD OF LAND CORNER MONUMENTATION

**History of original corner establishment:**

This corner was originally established by Leland Myers, ORLS 699, in 1967. See Map No. 10S-35 1/2 E and corner certificate.

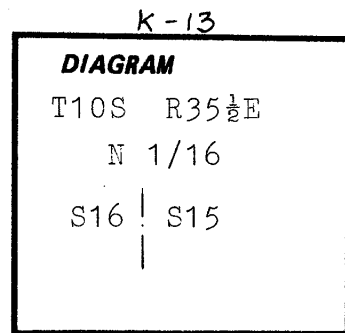

**Description of corner evidence found:**

Found Myers 2' by 5/8" rebar, with 1 1/2" aluminum cap, marked as per corner certificate, protruding 8" from the ground.

REGISTERED  
 PROFESSIONAL  
 LAND SURVEYOR

*William R. Wells*

OREGON  
 JULY 22, 1977  
 WILLIAM R. WELLS  
 1106

**Description of monument and accessories I established to perpetuate the original location of this corner:**

Set a 2 1/2" by 30" aluminum pipe with 2 1/2" aluminum cap, 18" in the ground and surrounded with a mound of earth and stone. Placed Myers monument inside the new monument. From the new monument:

A 6" Ponderosa Pine bears S 24 1/2° W - 10.3', scribed: N 1/16 S16 BT.

A 11" Douglas Fir bears S 55 1/2° E - 22.4', scribed: N 1/16 S15 BT.

New bearing trees have a brass washer stamped PLS 1106 nailed to face of blaze. Attached signs 54-3 and 54-9, and painted face of blaze and a 6" red band around each bearing tree.

Set steel fence posts on National Forest Boundary North and East of corner and attached sign 54-9 to one post, and sign 54-2 to both posts.

Used steel tape and staff compass with 19° E declination, measured to the center of the bearing trees.

This corner was remonumented on June 30, 1986.

Witnessed by: Willard Hulick.

Cap is marked:

T10S R35 1/2 E

N 1/16

S16 | S15

1986

PLS 1106

Office of.....County Surveyor..... County of.....Baker.....  
State of.....Oregon....., I hereby certify that the within instrument was filed in this office  
for record on the..... day of....., 19.....

..... by .....

(COUNTY OFFICIAL)

(DEPUTY)

FILED 7-21-86

BAKER COUNTY SURVEYOR

SURVEY NO. 10-353-180

830