


CERTIFIED RECORD OF LAND CORNER MONUMENTATION

K-19

History of original corner establishment:

A corner monument for this corner was established by survey by Leland Myers, LS 699, during 1967. See Map No. 10S-35½-53, and corner certificate. The monument established by Myers bears S 80° 00' E - 11.7' from the monument set for corner on this survey.

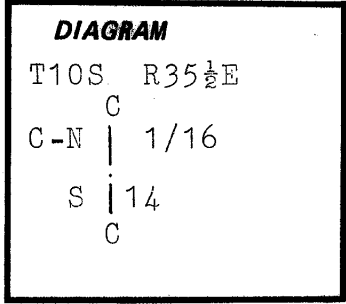

Description of corner evidence found:

None.

**REGISTERED
PROFESSIONAL
LAND SURVEYOR**

William R. Wells

**OREGON
JULY 22, 1977
WILLIAM R. WELLS
1106**

Description of monument and accessories | established to perpetuate the original location of this corner:

Set a 2½" aluminum pipe with 2½" aluminum cap 14" in the ground to bedrock and surrounded with a mound of earth and stone, from which:

A 9" Ponderosa Pine bears N 80° E - 10.2', scribed: C-N 1/16 S14 BT.

A 10" Ponderosa Pine bears S 8½° W - 10.7', scribed: C-N 1/16 S14 BT.

New bearing trees have a brass washer stamped PLS 1106 nailed to face of blaze. Attached signs 54-3 and 54-9, and painted face of blaze and a 6" red band around each bearing tree.

Set steel fence posts on National Forest Boundary East and West of corner, and attached sign 54-9 to one post and sign 54-2 to both posts.

Used steel tape and staff compass with 19°E declination, measured to the center of the bearing trees.

This corner was remonumented on June 24, 1986.

Witnessed by: Willard Hulick.

Cap is marked:
T10S R35½E
C
C-N | 1/16
S | 14
C
1986
PLS 1106

Office of.....County Surveyor..... County of..... Baker
Oregon
State of....., I hereby certify that the within instrument was filed in this office
for record on the..... day of....., 19.....
..... by
(COUNTY OFFICIAL) (DEPUTY)

FILED 7-21-86
BAKER COUNTY SURVEYOR
SURVEY NO. 10-35½-183

183