


CERTIFIED RECORD OF LAND CORNER MONUMENTATION

K-20

**History of original corner establishment:**

The corner was established by Leland Myers, LS 699, during 1967. See map No. 10S-35½-53, and corner certificate.

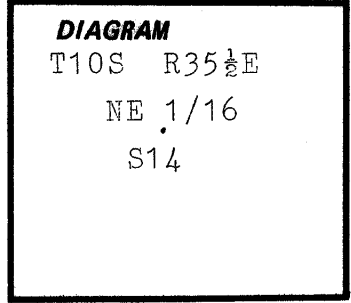

**Description of corner evidence found:**

Found Myer's monument, destroyed by logging, is lying N 82½° E - 8' from corner position determined on this survey.

REGISTERED PROFESSIONAL LAND SURVEYOR
---

*William R. Wells*

OREGON JULY 22, 1977 WILLIAM R. WELLS 1106
---

**Description of monument and accessories established to perpetuate the original location of this corner:**

Set a 2½" by 30" aluminum pipe with 2½" aluminum cap 20" in the ground and surrounded with a mound of earth and stone, from which:

A 10" Ponderosa Pine bears N 24° E - 67.2', scribed: NE 1/16 S14 BT.

A 6" Ponderosa Pine bears N 77½° W - 37.3', scribed: NE 1/16 S14 BT.

New bearing trees have a brass washer stamped PLS 1106 nailed to face of blaze. Attached signs 54-3 and 54-9, and painted face of blaze and a 6" red band around each bearing tree.

Set steel fence posts on National Forest Boundary West and North of corner and attached sign 54-9 to one post, and sign 54-2 to both posts.

Used steel tape and staff compass with 19° E declination, measured to the center of the bearing trees.

This corner was remonumented on June 24, 1986.

Witnessed by: Willard Hulick.

Cap is marked:

T10 S R35½E

NE 1/16

S14

1986

PLS 1106

Office of..... County Surveyor..... County of..... Baker

State of..... Oregon....., I hereby certify that the within instrument was filed in this office

for record on the..... day of....., 19.....

..... by .....

(COUNTY OFFICIAL)

(DEPUTY)