


CERTIFIED RECORD OF LAND CORNER MONUMENTATION

L-15

History of original corner establishment:

None.

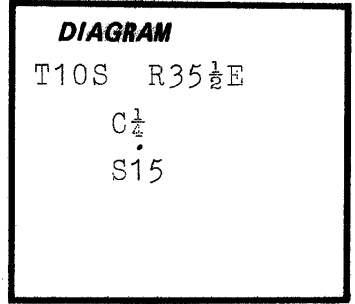

No evidence of corner establishment found in County Records.

Description of corner evidence found:

None. Corner set by survey.

Description of monument and accessories established to perpetuate the original location of this corner:

Set a 2½" by 30" aluminum pipe with 2½" aluminum cap 24" in the ground and surrounded with a mound of earth and stone, from which:

A 16" White Fir bears N 45° W - 44.0', scribed: C½ S15 BT.

A 15" White Fir bears S 35½° W - 52.5', scribed: C½ S15 BT.

New bearing trees have a brass washer stamped PLS 1106 nailed to face of blaze. Attached signs 54-3 and 54-9, and painted face of blaze and a 6" red band around each bearing tree.

Set steel fence post North of corner and attached sign 54-9.

Used steel tape and staff compass with 20°E declination, measured to the center of the bearing trees.

This corner was monumented on June 13, 1986.

Witnessed by: Willard Hulick.

**REGISTERED
PROFESSIONAL
LAND SURVEYOR**

William R. Wells

**OREGON
JULY 22, 1977
WILLIAM R. WELLS
1106**

Cap is marked:

T10S R35½E

C½

S15

1986
PLS 1106

Office of.....County Surveyor..... County of..... Baker.....

State of.....Oregon....., I hereby certify that the within instrument was filed in this office for record on the..... day of....., 19.....

..... by
(COUNTY OFFICIAL) (DEPUTY)

FILED 7-21-86
BAKER COUNTY SURVEYOR
SURVEY NO. 10-35½-185