


CERTIFIED RECORD OF LAND CORNER MONUMENTATION

History of original corner establishment:

This corner was established by Leland Myers, LS 699 in 1967. See Map No. 10S-35½E-53, and corner certificate.

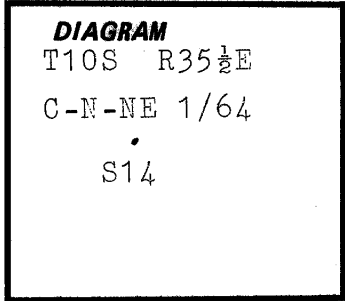

Description of corner evidence found:

Found L. Myers 5/8" by 2' rebar with no cap, lying down. Could not determine exact position of where Myers monument was, but it appears to have been located about where corner point by this survey falls.

REGISTERED
PROFESSIONAL
LAND SURVEYOR

William R. Wells

OREGON
JULY 22, 1977
WILLIAM R. WELLS
1106

Description of monument and accessories established to perpetuate the original location of this corner:

Set a 2½" by 30" aluminum pipe with 2½" aluminum cap. Due to mudstone at the corner point, we positioned the monument in a crack in the rock and surrounded with a substantial mound of stone. Placed Myers monument inside our new monument. From the new monument:

A 6" Juniper bears N 9½° W - 30.2', scribed: C-N-NE 1/64 S14 BT.

A 17" Juniper bears S 39½° E - 68.8', scribed: C-N-NE 1/64 S14 BT.

New bearing trees have a brass washer stamped PLS 1106 nailed to face of blaze. Attached signs 54-3 and 54-9, and painted face of blaze and a 6" red band around each bearing tree.

Set steel fence posts on National Forest Boundary West and South of the corner and attached sign 54-9 to one post, and sign 54-2 to both posts.

Used steel tape and staff compass with 19°E declination, measured to the center of the bearing trees.

This corner was remonumented on June 24, 1986.

Cap is marked:

T10S R35½E

C-N-NE 1/64

S14

1986

PLS 1106

Witnessed by: Willard Hulick.

Office of..... County Surveyor..... County of..... Baker.....
State of..... Oregon....., I hereby certify that the within instrument was filed in this office
for record on the..... day of....., 19.....
..... by
(COUNTY OFFICIAL) (DEPUTY)

FILED 7-21-86
BAKER COUNTY SURVEYOR
SURVEY NO. 10-35½-187