


CERTIFIED RECORD OF LAND CORNER MONUMENTATION

History of original corner establishment:

The corner was originally established by Leland Myers in 1967. See Map No. 10S-35 $\frac{1}{2}$ -53, and corner certificate.

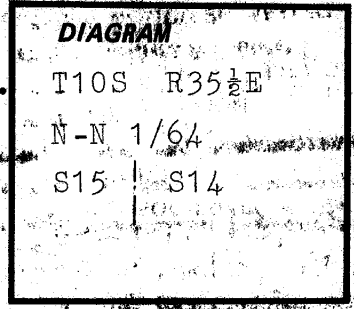

Description of corner evidence found:

Found Myers 2' by 5/8" rebar with 1 $\frac{1}{2}$ " aluminum cap, marked as shown on corner certificate, protruding 6" from a stone mound.

**REGISTERED
PROFESSIONAL
LAND SURVEYOR**

William R. Wells

**OREGON
JULY 22, 1977
WILLIAM R. WELLS
1106**

Description of monument and accessories I established to perpetuate the original location of this corner:

Set a 2 $\frac{1}{2}$ " by 30" aluminum pipe with 2 $\frac{1}{2}$ " aluminum cap 18" in the ground and surrounded with a mound of earth and stone. Place Myers monument inside our new monument. From the new monument:

Note: Had to tilt monument slightly due to large tree roots. From monument:

A 7" Douglas Fir bears N 45 $\frac{1}{2}$ $^{\circ}$ E - 34.0', scribed: N N 1/64 S14 BT.

A 14" Ponderosa Pine bears N 58 $^{\circ}$ W - 19.6', scribed: N N 1/64 S15 BT.

New bearing trees have a brass washer stamped PLS 1106 nailed to face of blaze. Attached signs 54-3 and 54-9, and painted face of blaze and a 6" red band around each bearing tree.

Set steel fence posts on National Forest Boundary North and East of corner and attached sign 54-9 to one post, and sign 54-2 to both posts.

Used steel tape and staff compass with 19 $^{\circ}$ E declination, measured to the center of the bearing trees.

This corner was remonumented on June 30, 1986.

Witnessed by: Willard Hulick.

Cap is marked:
T10S R35 $\frac{1}{2}$ E
N-N 1/64
S15 | S14
1986
PLS 1106

Office of..... County Surveyor..... County of..... Baker.....
State of..... Oregon..... I hereby certify that the within instrument was filed in this office
for record on the..... day of....., 19.....
..... by

(COUNTY OFFICIAL)

(DEPUTY)