


CERTIFIED RECORD OF LAND CORNER MONUMENTATION

History of original corner establishment:

This corner was originally established by Leland Myers in 1968. See Map No. 10S-35½E-53, and the corner certificate.

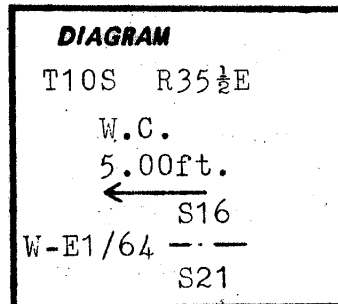

Description of corner evidence found:

Found a 2" brass cap on 1" flanged GIP protruding 12" from a mound of stone. This location was monumented by Leland Myers and the cap is marked as per the recorded corner certificate. Myers corner location was not accepted because of additional original evidence recovered as part of this survey. Myers monument bears S 49° 34' W - 28.2' from corner position determined on this survey.

**REGISTERED
PROFESSIONAL
LAND SURVEYOR**

William R. Wells

**OREGON
JULY 22, 1977
WILLIAM R. WELLS
1106**

Description of monument and accessories established to perpetuate the original location of this corner:

The corner position falls on a scrawny, twisted Douglas Fir unsuitable for marking as a corner tree. Set a 2½" aluminum pipe with 2½" aluminum cap witness corner 8" in the ground to bedrock and surrounded with a mound of earth and stone. The witness corner is located on the section line common to sections 16 and 21, a distance of 5.00' East of true corner position. From the new monument:

A 6" White Fir bears S 54° W - 65.3', scribed: "X" at breast height & BT at base.

A 9" Ponderosa Pine bears N 16½° W - 63.6', scribed: "X" at breast height & BT at base.

New bearing trees have a brass washer stamped PLS 1106 nailed to face of blaze. Attached signs 54-3 and 54-9 and painted face of blaze and a 6" red band around each bearing tree.

Set steel fence posts West and South of true corner position and attached sign 54-9 to one post and sign 54-2 to both posts.

Used steel tape and staff compass with 19°E declination, measured to the center of the bearing trees.

This corner was remonumented on July 2, 1986.

Witnessed by: Willard Hulick.

Cap is marked:
T10S R35½E
W.C.
5.00ft.
← S16
W-E1/64 ---
S21
1986
PLS 1106

Office of.....County Surveyor..... County of.....Baker.....
State of.....Oregon....., I hereby certify that the within instrument was filed in this office
for record on the..... day of....., 19.....
..... by
(COUNTY OFFICIAL) (DEPUTY)

FILED 9-15-86
BAKER COUNTY SURVEYOR
SURVEY 10-35½-191