


CERTIFIED RECORD OF LAND CORNER MONUMENTATION

History of original corner establishment:

None. Corner never set.

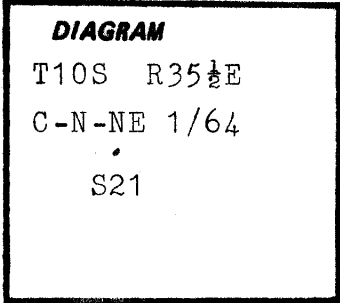

No evidence of corner establishment found in County Records.

Description of corner evidence found:

None.

**REGISTERED
PROFESSIONAL
LAND SURVEYOR**

William R. Wells

**OREGON
JULY 22, 1977
WILLIAM R. WELLS
1106**

Description of monument and accessories I established to perpetuate the original location of this corner:

Set a 2½" by 30" aluminum pipe with 2½" aluminum cap 24" in the ground and surrounded with a mound of earth and stone, from which:

A 11" Douglas Fir bears S 80½° E - 25.2', scribed: C-N-NE 1/64 S21 BT.

A 9" White Fir bears N 23½° E - 26.8', scribed: C-N-NE 1/64 S21 BT.

New bearing trees have a brass washer stamped PLS 1106 nailed to face of blaze. Attached signs 54-3 and 54-9, and painted face of blaze and a 6" red band around each bearing tree.

Set steel fence posts on National Forest Boundary North and West of corner and attached sign 54-9 to one post, and sign 54-2 to both posts.

Used steel tape and staff compass with 19°E declination, measured to the center of the bearing trees.

This corner was monumented on July 3, 1986.

Witnessed by: Willard Hulick.

Cap is marked:

T10S R35½E

C-N-NE 1/64

S21

1986

PLS 1106

Office of.....County Surveyor..... County of..... Baker.....
State of..... Oregon....., I hereby certify that the within instrument was filed in this office
for record on the..... day of....., 19.....
..... by

(COUNTY OFFICIAL)

(DEPUTY)