


**CERTIFIED RECORD OF LAND CORNER MONUMENTATION**

**History of original corner establishment:**

This corner was originally established by W. B. Barr, U. S. Deputy Surveyor, under Contract No. 492 dated August 22, 1883. The original notes state that at the corner a 14" by 10" by 6" basalt stone was set for the corner, marked 1/4 on North face, from which:

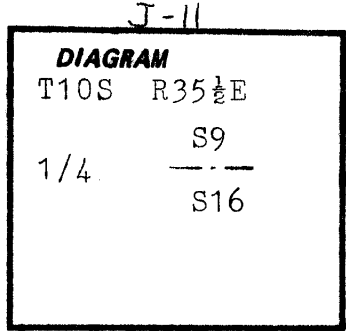

A 36" Pine bears N 75° E - 51 lk., marked: 1/4 S BT.

A 6" Fir bears S 20° W - 21 lk., marked: 1/4 S BT.

In 1967, this corner was supposedly re-established by Leland Myers. See Map No. 10S-35 1/2 E-53, and corner certificate.

**Description of corner evidence found:**

Found a sawed, rotted 36" Ponderosa Pine stump which bears N 78° E - 33.7' to blaze face, 35.2' to centerline with no remaining scribing. A rotted Fir stump bears S 20° W - 13.9' to where blaze face would have been, and 14.2' to centerline. Axe marks are visible. A 5/8" rebar by Myers, set in 1967, protrudes 6" from a stone mound, and bears N 77° 19' W - 16 1/2'. Found 14" by 10" by 6" broken original stone, marks "1/4" clearly visible; in Myers stone mound. Original topo. call to brook to East matches our corner position. A Burnt River Lumber Co. tag is on Lodgepole Pine 5' West of Ponderosa Pine bearing tree stump.

**Description of monument and accessories I established to perpetuate the original location of this corner:**

Set a 2 1/2" aluminum pipe with 2 1/2" aluminum cap 24" in the ground and surrounded with a mound of earth and stone. Placed corner stone in the mound. From the new monument:

A 6" Western Larch bears N 35° E - 29.5', scribed: 1/4 S9 BT.

A 13" Ponderosa Pine bears S 73° E - 35.5', scribed: 1/4 S16 BT.

New bearing trees have a brass washer stamped PLS 1106 nailed to face of blaze. Attached signs 54-3 and 54-9, and painted face of blaze and a 6" red band around each bearing tree.

Set steel fence post West of corner and attached sign 54-9.

Used steel tape and staff compass with 19° E declination, measured to the center of the bearing trees.

This corner was remonumented on July 3, 1986.

Witnessed by: Willard Hulick.

Cap is marked:  
T10S R35 1/2 E  
1/4      S9  
            -----  
            S16  
1986  
PLS 1106

**REGISTERED  
PROFESSIONAL  
LAND SURVEYOR**

*William R. Wells*

**OREGON  
JULY 22, 1977  
WILLIAM R. WELLS  
Baker**

Office of..... County Surveyor .....  
State of..... Oregon ..... I hereby certify that the within instrument was filed in this office  
for record on the..... day of....., 19.....  
..... by .....  
(COUNTY OFFICIAL) (DEPUTY)