


CERTIFIED RECORD OF LAND CORNER MONUMENTATION

L-9

History of original corner establishment:

This corner was originally established by Eugene P. McCornack, U. S. Deputy Surveyor, under Contract No. 398, dated July 2, 1881. The original notes state that at the corner a 14" by 12" by 10" marked basalt stone was set 10" in the ground, from which:

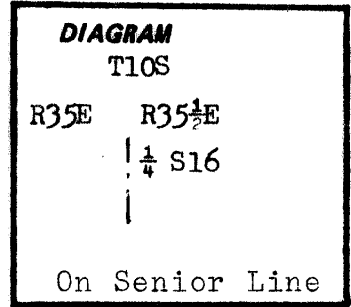

A 48" Pine bears S 30° E - 78 lks., marked: 1/4 S BT.

A 48" Pine bears S 30° W - 54 lks., marked: 1/4 S BT.

This corner was remonumented by Leland Myers in 1968.

Description of corner evidence found:

Found the 2" brass cap on 1" flanged GIP set by Myers in 1968, and maintained by this surveyor in 1985. See recorded corner certificate.

The corner is located N 88° 31' 17" E - 6.01' from amended monument for 1/4 S16. See corner certificates.

REGISTERED
PROFESSIONAL
LAND SURVEYOR

William R. Wells

OREGON
JULY 22, 1977
WILLIAM R. WELLS
1106

Description of monument and accessories established to perpetuate the original location of this corner:

Set a 2 1/2" by 30" aluminum pipe with 2 1/2" aluminum cap 24" in the ground and surrounded with a mound of earth and stone.

Note: Marked "AM" on East side of 1/4" on Myers monument. Marked the 54-3 tags for the amended monument "AM".

Utilized existing bearing trees marked in 1985 for the amended monument. Tagged trees with additional 54-3 sign. From the W 1/4 S16 on senior line:

A 14" Ponderosa Pine bears S 84° E - 26.7', scribed: 1/4 S16 BT.

A 13" Ponderosa Pine bears S 37 1/2° E - 57.1', scribed: 1/4 S16 BT.

A 9" Ponderosa Pine bears N 12 1/2° E - 19.7', scribed: 1/4 S16 BT.


Set steel fence post North of corner and attached sign 54-9.

Used steel tape and staff compass with 20° E declination, measured to the center of the bearing trees.

This corner was remonumented on July 9, 1986.

Witnessed by: Willard Hulick.

Cap is marked:

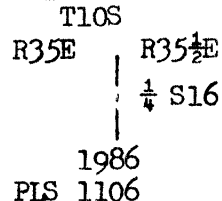

Office of..... County Surveyor..... County of..... Baker.....
State of..... Oregon....., I hereby certify that the within instrument was filed in this office
for record on the..... day of....., 19.....
..... by
(COUNTY OFFICIAL) (DEPUTY)