


CERTIFIED RECORD OF LAND CORNER MONUMENTATION

L-11

History of original corner establishment:

None. The corner was never set.

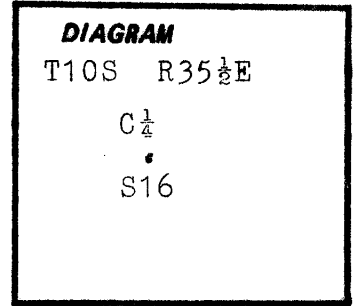

No evidence of corner establishment found in County Records.

Description of corner evidence found:

None.

Description of monument and accessories I established to perpetuate the original location of this corner:

Set a 2½" aluminum pipe with 2½" aluminum cap 10" in the ground to rock, and surrounded with a mound of earth and stone, from which:

A 10" Ponderosa Pine bears N 77½° E - 12.1', scribed: C¼ S16 BT.

A 16" Ponderosa Pine bears N 2½° E - 80.3', scribed: C¼ S16 BT.

New bearing trees have a brass washer stamped PLS 1106 nailed to face of blaze. Attached signs 54-3 and 54-9, and painted face of blaze and a 6" red band around each bearing tree.

Set steel fence post East of corner and attached sign 54-9.

Used steel tape and staff compass with 19°E declination, measured to the center of the bearing trees.

This corner was monumented on July 8, 1986.

Witnessed by: Willard Hulick.

REGISTERED PROFESSIONAL LAND SURVEYOR

William R. Wells

OREGON JULY 22, 1977 WILLIAM R. WELLS 1106

Cap is marked:

T10S R35½E

C¼

•
S16

1986

PLS 1106

Office of.....County Surveyor..... County of.....Baker.....

State of.....Oregon....., I hereby certify that the within instrument was filed in this office

for record on the..... day of....., 19.....

..... by

(COUNTY OFFICIAL)

(DEPUTY)