


CERTIFIED RECORD OF LAND CORNER MONUMENTATION

M-12

History of original corner establishment:

This corner was originally established by Leland Myers in 1968. See Map No. 10S-35½E-53, and corner certificate.

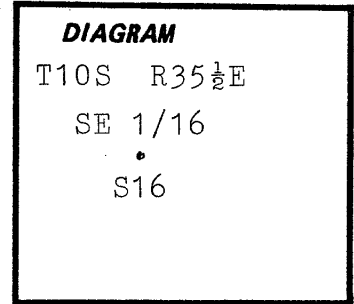

Description of corner evidence found:

A 2" brass cap on 1" flanged G.I.P. by Myers, marked as shown on corner certificate, was found protruding 6" from the ground S 19° 14' W - 16.9' from the corner position determined on this survey. Myers monument was not accepted because of additional original evidence recovered on this survey.

Description of monument and accessories established to perpetuate the original location of this corner:

Set a 2½" by 30" aluminum pipe with 2½" aluminum cap 24" in the ground and surrounded with a mound of earth and stones, from which:

A 11" Douglas Fir bears N 45½° E - 34.9', scribed: SE 1/16 S16 BT.

A 14" Douglas Fir bears N 83½° E - 13.4', scribed: SE 1/16 S16 BT.

New bearing trees have a brass washer stamped PLS 1106 nailed to face of blaze. Attached signs 54-3 and 54-9, and painted face of blaze and a 6" red band around each bearing tree.

Set steel fence posts on National Forest Boundary South and West of corner and attached sign 54-9 to one post and sign 54-2 to both posts.

Used steel tape and staff compass with 19°E declination, measured to the center of the bearing trees.

This corner was remonumented on July 1, 1986.

Witnessed by: Willard Hulick.

REGISTERED
PROFESSIONAL
LAND SURVEYOR

William R. Wells

OREGON
JULY 22, 1977
WILLIAM R. WELLS
1106

Cap is marked:

T10S R35½E

SE 1/16

S16

1986

PLS 1106

Office of..... County Surveyor..... County of..... Baker.....
State of..... Oregon....., I hereby certify that the within instrument was filed in this office
for record on the..... day of....., 19.....

..... by
(COUNTY OFFICIAL) (DEPUTY)