


CERTIFIED RECORD OF LAND CORNER MONUMENTATION

N-9

History of original corner establishment:

This corner was originally established by Eugene P. McCornack, U. S. Deputy Surveyor, under Contract No. 398, dated July 2, 1881. The original notes state that at the corner a 20" by 14" by 12" marked basalt stone was set 15" in the ground, from which:

- A 48" Pine bears N 55° E 18 lks., marked: T10S R35½E S16 BT.
- A 30" Pine bears S 40° E 49 lks., marked: T10S R35½E S21 BT.

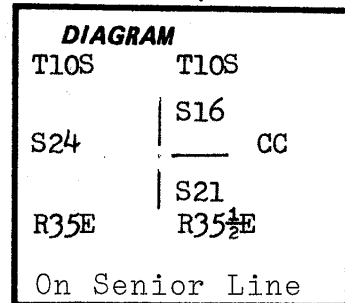

The corner was first remonumented from existing evidence by Leland Myers in 1968, and remonumented by PLS 1106 in 1985.

Description of corner evidence found:

Found 2½" aluminum cap on 2½" aluminum pipe, remonumenting the amended monument, remonumented in 1985. See recorded corner certificate.

The corner is located N 89° 04' 16" E - 5.10' from amended monument. See recorded corner certificate.

REGISTERED PROFESSIONAL LAND SURVEYOR
---

*William R. Wells*

OREGON JULY 22, 1977 WILLIAM R. WELLS 1106
---

Description of monument and accessories established to perpetuate the original location of this corner:

Set a 2½" aluminum pipe with 2½" aluminum cap 19" in the ground to bedrock and surrounded with a mound of earth and stone.

Note: Marked "AM" on monument set in 1985 above the "CC". Marked 54-3 signs on bearing trees referencing amended monuments "AM".

Utilized existing original bearing trees to reference new monument. Placed an additional 54-3 sign on bearing trees referencing new monument. From the new monument:

- A 36" Ponderosa Pine bears N 38° E - 9.0' with scribing visible on partly healed double blazes.
- A 28" Ponderosa Pine bears S 30½° E - 29.4' with scribing visible on partly healed double blazes.

Set steel fence post North of corner and attached sign 54-9.

Used steel tape and staff compass with 20°E declination, measured to the center of the bearing trees.

This corner was remonumented on July 11, 1986.

Witnessed by: Willard Hulick.

Cap is marked:	
T10S	T10S
	S16
S24	_____ CC
	S21
R35E	R35½E
	1986
	PLS 1106

Office of.....County Surveyor..... County of.....Baker.....  
 State of.....Oregon....., I hereby certify that the within instrument was filed in this office  
 for record on the..... day of....., 19.....  
 ..... by .....  
 (COUNTY OFFICIAL) (DEPUTY)