


CERTIFIED RECORD OF LAND CORNER MONUMENTATION

N-12

**History of original corner establishment:**

This corner was originally established by Leland Myers in 1968. See Map No. 10S-35½E-53, and the corner certificate.

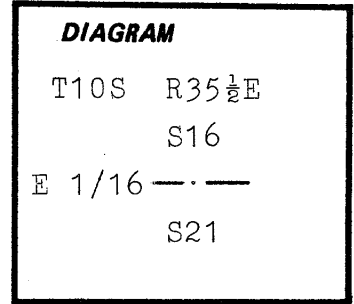

**Description of corner evidence found:**

Found a 2" brass cap on 1" flanged G.I.P. protruding 12" from a mound of stone. Cap is marked as shown on recorded corner certificate. Myers monument bears S 58° 36' W - 23.3' from corner position established on this survey. Myers monument was not accepted because of additional original evidence recovered on this survey.

**Description of monument and accessories established to perpetuate the original location of this corner:**

Set a 2½" by 30" aluminum pipe with 2½" aluminum cap 15" in the ground and surrounded with a mound of earth and stone, from which:

A 9" White Fir bears N 85½° W - 13.4', scribed: E 1/16 S16 BT.

A 6" Juniper bears S 24½° E - 58.1', scribed: E 1/16 S21 BT.

New bearing trees have a brass washer stamped PLS 1106 nailed to face of blaze. Attached signs 54-3 and 54-9 and painted face of blaze and a 6" red band around each bearing tree.

Set steel fence posts on National Forest Boundary North and South of corner and attached sign 54-9 to one post, and sign 54-2 to both posts.

Used steel tape and staff compass with 19°E declination, measured to the center of the bearing trees.

This corner was remonumented on July 2, 1986.

Witnessed by: Willard Hulick.

<b>REGISTERED PROFESSIONAL LAND SURVEYOR</b>
--

*William R. Wells*

<b>OREGON JULY 22, 1977 WILLIAM R. WELLS 1106</b>
---

Cap is marked:

T10S	R35½E
	S16
E 1/16	— · —
	S21

1986  
PLS 1106

Office of.....County Surveyor..... County of.....Baker.....  
State of.....Oregon..... I hereby certify that the within instrument was filed in this office  
for record on the..... day of....., 19.....

..... by .....  
(COUNTY OFFICIAL) (DEPUTY)