


CERTIFIED RECORD OF LAND CORNER MONUMENTATION

History of original corner establishment:

This corner was originally established by Eugene P. McCornack, U. S. Deputy Surveyor, under Contract No. 398, dated July 2, 1881. The original notes state that at the corner a 20" by 14" by 14" marked basalt stone was set 15" in the ground, from which:

A 36" Pine bears N 90° E 11 lks., marked: 1/4 S BT.

A 30" Pine bears N 25° W 50 lks., marked: 1/4 S BT.

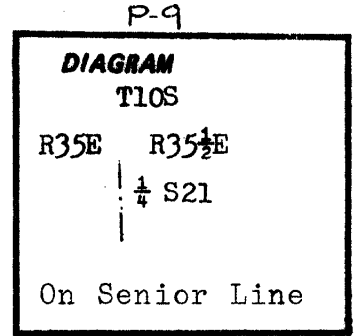


This corner was remonumented from existing evidence in 1985.

Description of corner evidence found:

Found amended monument for 1/4 S 21 - a 2 1/2" aluminum pipe with 2 1/2" aluminum cap. See recorded corner certificate.

The corner is located S 89° 50' 53" E - 11.13' from amended monument for 1/4 S21. See recorded corner certificate.

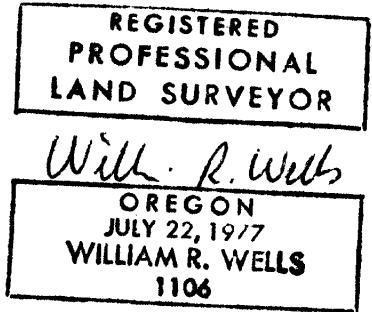

Description of monument and accessories established to perpetuate the original location of this corner:

Set a 2 1/2" aluminum pipe with 2 1/2" aluminum cap 22" in the ground and surrounded with a mound of earth and stone.

Note: Marked "AM" below 1/4 S21 on cap on the monument set in 1985. Marked 54-3 tags for amended monument "AM".

Utilized existing bearing trees marked in 1985 for the amended monument; tagged trees with additional 54-3 sign. From W 1/4 S21 on senior line:

8" Juniper bears S 22 1/2° E - 48.8', scribed: 1/4 S21 BT.

10" White Fir bears N 65° E - 21.8', scribed: 1/4 S21 BT.

Set steel fence post North of corner and attached sign 54-9.

Used steel tape and staff compass with 20° E declination, measured to the center of the bearing trees.

This corner was remonumented on July 9, 1986.

Witnessed by: Willard Hulick.

Cap is marked:
T10S
R35E R35 1/2 E
| 1/4 S21
1986
PLS 1106

Office of.....County Surveyor.....County of.....**Baker**.....
State of.....**Oregon**....., I hereby certify that the within instrument was filed in this office
for record on the..... day of....., 19.....
..... by
(COUNTY OFFICIAL) (DEPUTY)