


CERTIFIED RECORD OF LAND CORNER MONUMENTATION

History of original corner establishment:

None. The corner was never set.

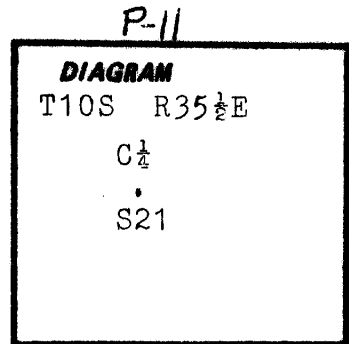

No evidence of corner establishment found in County Records.

Description of corner evidence found:

Nothing official. A blazed 20" Western Larch bears West 20'.

Description of monument and accessories I established to perpetuate the original location of this corner:

Set a 2½" aluminum pipe with 2½" aluminum cap 24" in the ground and surrounded with a mound of earth and a few stones, from which:

A 10" White Fir bears S 66½° W - 23.2', scribed: C¼ S21 BT.

A 11" White Fir bears S 41½° E - 10.0', scribed: C¼ S21 BT.

New bearing trees have a brass washer stamped PLS 1106 nailed to face of blaze. Attached signs 54-9 and 54-3, and painted face of blaze and a 6" red band around each bearing tree.

Set steel fence post North of corner, and attached sign 54-9.

Used steel tape and staff compass with 19°E declination, measured to the center of the bearing trees.

This corner was monumented on July 9, 1986.

Cap is marked:

Witnessed by: Willard Hulick.

**REGISTERED
PROFESSIONAL
LAND SURVEYOR**

William R Wells

**OREGON
JULY 22, 1977
WILLIAM R. WELLS
1106**

T10S R35½E

C¼

•

S21

1986

PLS 1106

Office of.....County Surveyor..... County of..... Baker

State of.....Oregon....., I hereby certify that the within instrument was filed in this office

for record on the..... day of....., 19.....

..... by

(COUNTY OFFICIAL)

(DEPUTY)