


CERTIFIED RECORD OF LAND CORNER MONUMENTATION

History of original corner establishment:

This corner was originally established by Eugene P. McCormack, U. S. Deputy Surveyor, under Contract No. 398, dated July 2, 1881. The original notes state that at the corner a 18" by 10" by 10" marked basalt stone was set 12" in the ground, from which:

A 22" Fir bears N 10° E 65 lks., marked: T10S R35½E S21 BT.

A 36" Fir bears S 85° E 50 lks., marked: T10S R35½E S28 BT.

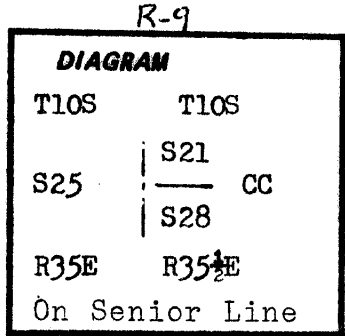

This corner was remonumented in 1985 by PLS 1106.

Description of corner evidence found:

Found a 2½" aluminum pipe with 2½" aluminum cap, set from existing evidence in 1985. See recorded corner certificate. This is the amended monument for the corner. The corner on senior line is located N 89° 39' 44" E - 2.66' from amended monument set in 1985. See recorded corner certificate.

REGISTERED  
PROFESSIONAL  
LAND SURVEYOR

*Will R. Wells*

OREGON  
JULY 22, 1977  
WILLIAM R. WELLS  
1106

Description of monument and accessories established to perpetuate the original location of this corner:

Set a 2½" by 30" aluminum pipe with 2½" aluminum cap 26" in the ground and surrounded with a mound of earth and stone.

Note: Marked "AM" on the amended monument set in 1985 above the "CC" on cap. Marked 54-3 signs referencing the amended monument "AM".

Utilized the bearing tree established for amended monument in 1985 for Section 28. Placed additional 54-3 sign on the bearing tree referencing the monument on the senior line. From the new monument:

9" White Fir bears S 28½° E - 24.7', scribed: T10S R35½E S28 BT.

Established 1 new bearing tree for the new monument:

10" Douglas Fir bears N 23½° E - 19.8', scribed: T10S R35½E S21 CC BT.


New bearing trees have a brass washer stamped PLS 1106 nailed to face of blaze. Attached signs 54-3 and 54-9 and painted face of blaze and a 6" red band around new bearing trees.

Set steel fence post East of corner and attached sign 54-9.

Used steel tape and staff compass with 20° E declination, measured to the center of the bearing trees.

This corner was remonumented on July 11, 1986.

Witnessed by: Willard Hulick.

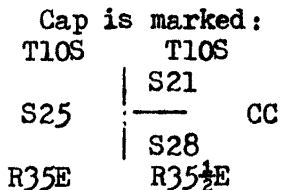

Office of..... County Surveyor..... County of..... Baker..... 1986  
State of..... Oregon..... I hereby certify that the within instrument was filed in this office PLS 1106  
for record on the..... day of....., 19.....  
..... by .....

(COUNTY OFFICIAL)

(DEPUTY)