


CERTIFIED RECORD OF LAND CORNER MONUMENTATION

History of original corner establishment:

This corner was originally established by Eugene P. McCornack, U. S. Deputy Surveyor, under Contract No. 398, dated July 2, 1881. The original notes state that at the corner a 14" by 14" by 10" marked basalt stone was set 9" in the ground, from which:

- A 36" Pine bears N 60° E - 42 lks., marked: 1/4 S BT.
- A 36" Pine bears S 50° W - 16 lks., marked: 1/4 S BT.

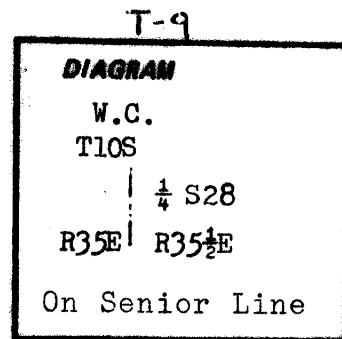

Description of corner evidence found:

None. Spent 2 hours searching with a 2 man crew, including 2 hours PLS time. The corner has been destroyed by the new road to Greenhorn.

Corner was re-established by proportional measure on the East line of T10S R35E, utilizing McCornack's retracement distances for proportioning.

REGISTERED
PROFESSIONAL
LAND SURVEYOR

William R. Wells

OREGON
JULY 22, 1977
WILLIAM R. WELLS
1106

Description of monument and accessories established to perpetuate the original location of this corner:

The corner falls in the cut bank of the Greenhorn Road, so set a witness corner N 0° 09' 22" W - 65.00' from the corner position. Set a 2 1/2" by 30" aluminum pipe with 2 1/2" aluminum cap 24" in the ground and surrounded with a mound of earth and stone, from which:

- A 10" Ponderosa Pine bears S 74 1/2° E - 31.2', scribed: "X" at breast height and BT at base.
- A 14" Ponderosa Pine bears S 20° E - 21.2', scribed: "X" at breast height and BT at base.


New bearing trees have a brass washer stamped PLS 1106 nailed to face of blaze. Attached signs 54-9 and 54-3, and painted face of blaze and a 6" red band around each bearing tree.

Set steel fence post North of corner and attached sign 54-9.

Used steel tape and staff compass with 19°E declination, measured to the center of the bearing trees.

This corner was remonumented on July 11, 1986.

Witnessed by: Willard Hulick.

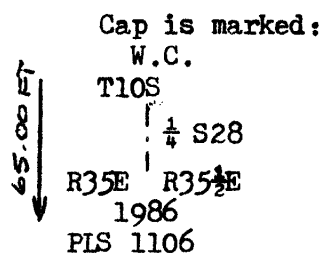

County Surveyor

Office of..... County of..... **Baker**
 State of..... **Oregon**....., I hereby certify that the within instrument was filed in this office
 for record on the..... day of....., 19.....
 by
 (COUNTY OFFICIAL) (DEPUTY)