


CERTIFIED RECORD OF LAND CORNER MONUMENTATION

INDEX No. T-24

History of original corner establishment:

Baker County Survey Records show no previous establishment of this Cor.

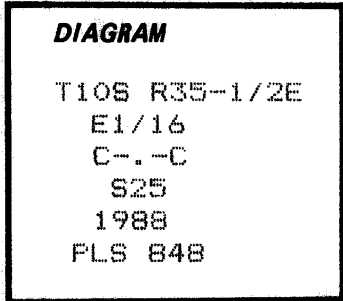

Description of corner evidence found:

Baker County Survey Records show no previous establishment of this corner. Found 20"x8"x6" stone with 1/16 on North face and FS on South face, set North alongside the position of this corner. Note: there is no record available referring to this stone, it looks like H.E. Merrymans work and in any case conforms nearly perfectly with this survey.

Description of monument and accessories established to perpetuate the original location of this corner:

Set 2-1/2"x30" aluminum pipe with 3-1/2" aluminum cap, stamped as shown on the **DIAGRAM**, SET 20" in the ground, set the above described stone in its original position North alongside pipe in a circle of stone.
From Which:
Ponderosa Pine 6" dia., Bears N35°09'W., 29.1 ft., scribed: X BT
Ponderosa Pine 12" dia., Bears N24°37'E., 58.6 ft., scribed: C-E 1/16 S25 BT
Measurements to trees taken with Electronic Tacheometer with bearings turned from the survey control network.
Nailed a brass washer stamped PLS 848 on blaze above BT scribe, Bearing Tree Sign above blaze, and warning sign on back of each tree. Painted a 6" red band at breast ht. around each tree. Set steel fence posts with warning & Boundary Signs, North & West 5 ft. from the corner.

**REGISTERED
PROFESSIONAL
LAND SURVEYOR**

**OREGON
JULY 12, 1968
DOUGLAS M. FERGUSON
848**

This work is performed by:
Douglas M. Ferguson PLS 848
Mt. Vernon Oregon.
On: Nov. 16, 1988
Refer to Map of Survey No. 10-35-1/2-208
Witnesses: D. Mitchell Ferguson & Ken Delano

Office of..... County of.....
State of....., I hereby certify that the within instrument was filed in this office
for record on the..... day of....., 19.....
..... by

(COUNTY OFFICIAL) (DEPUTY)

FILED March 30, 1989
BAKER COUNTY SURVEYOR
SURVEY NO. 10-35 1/2-214