


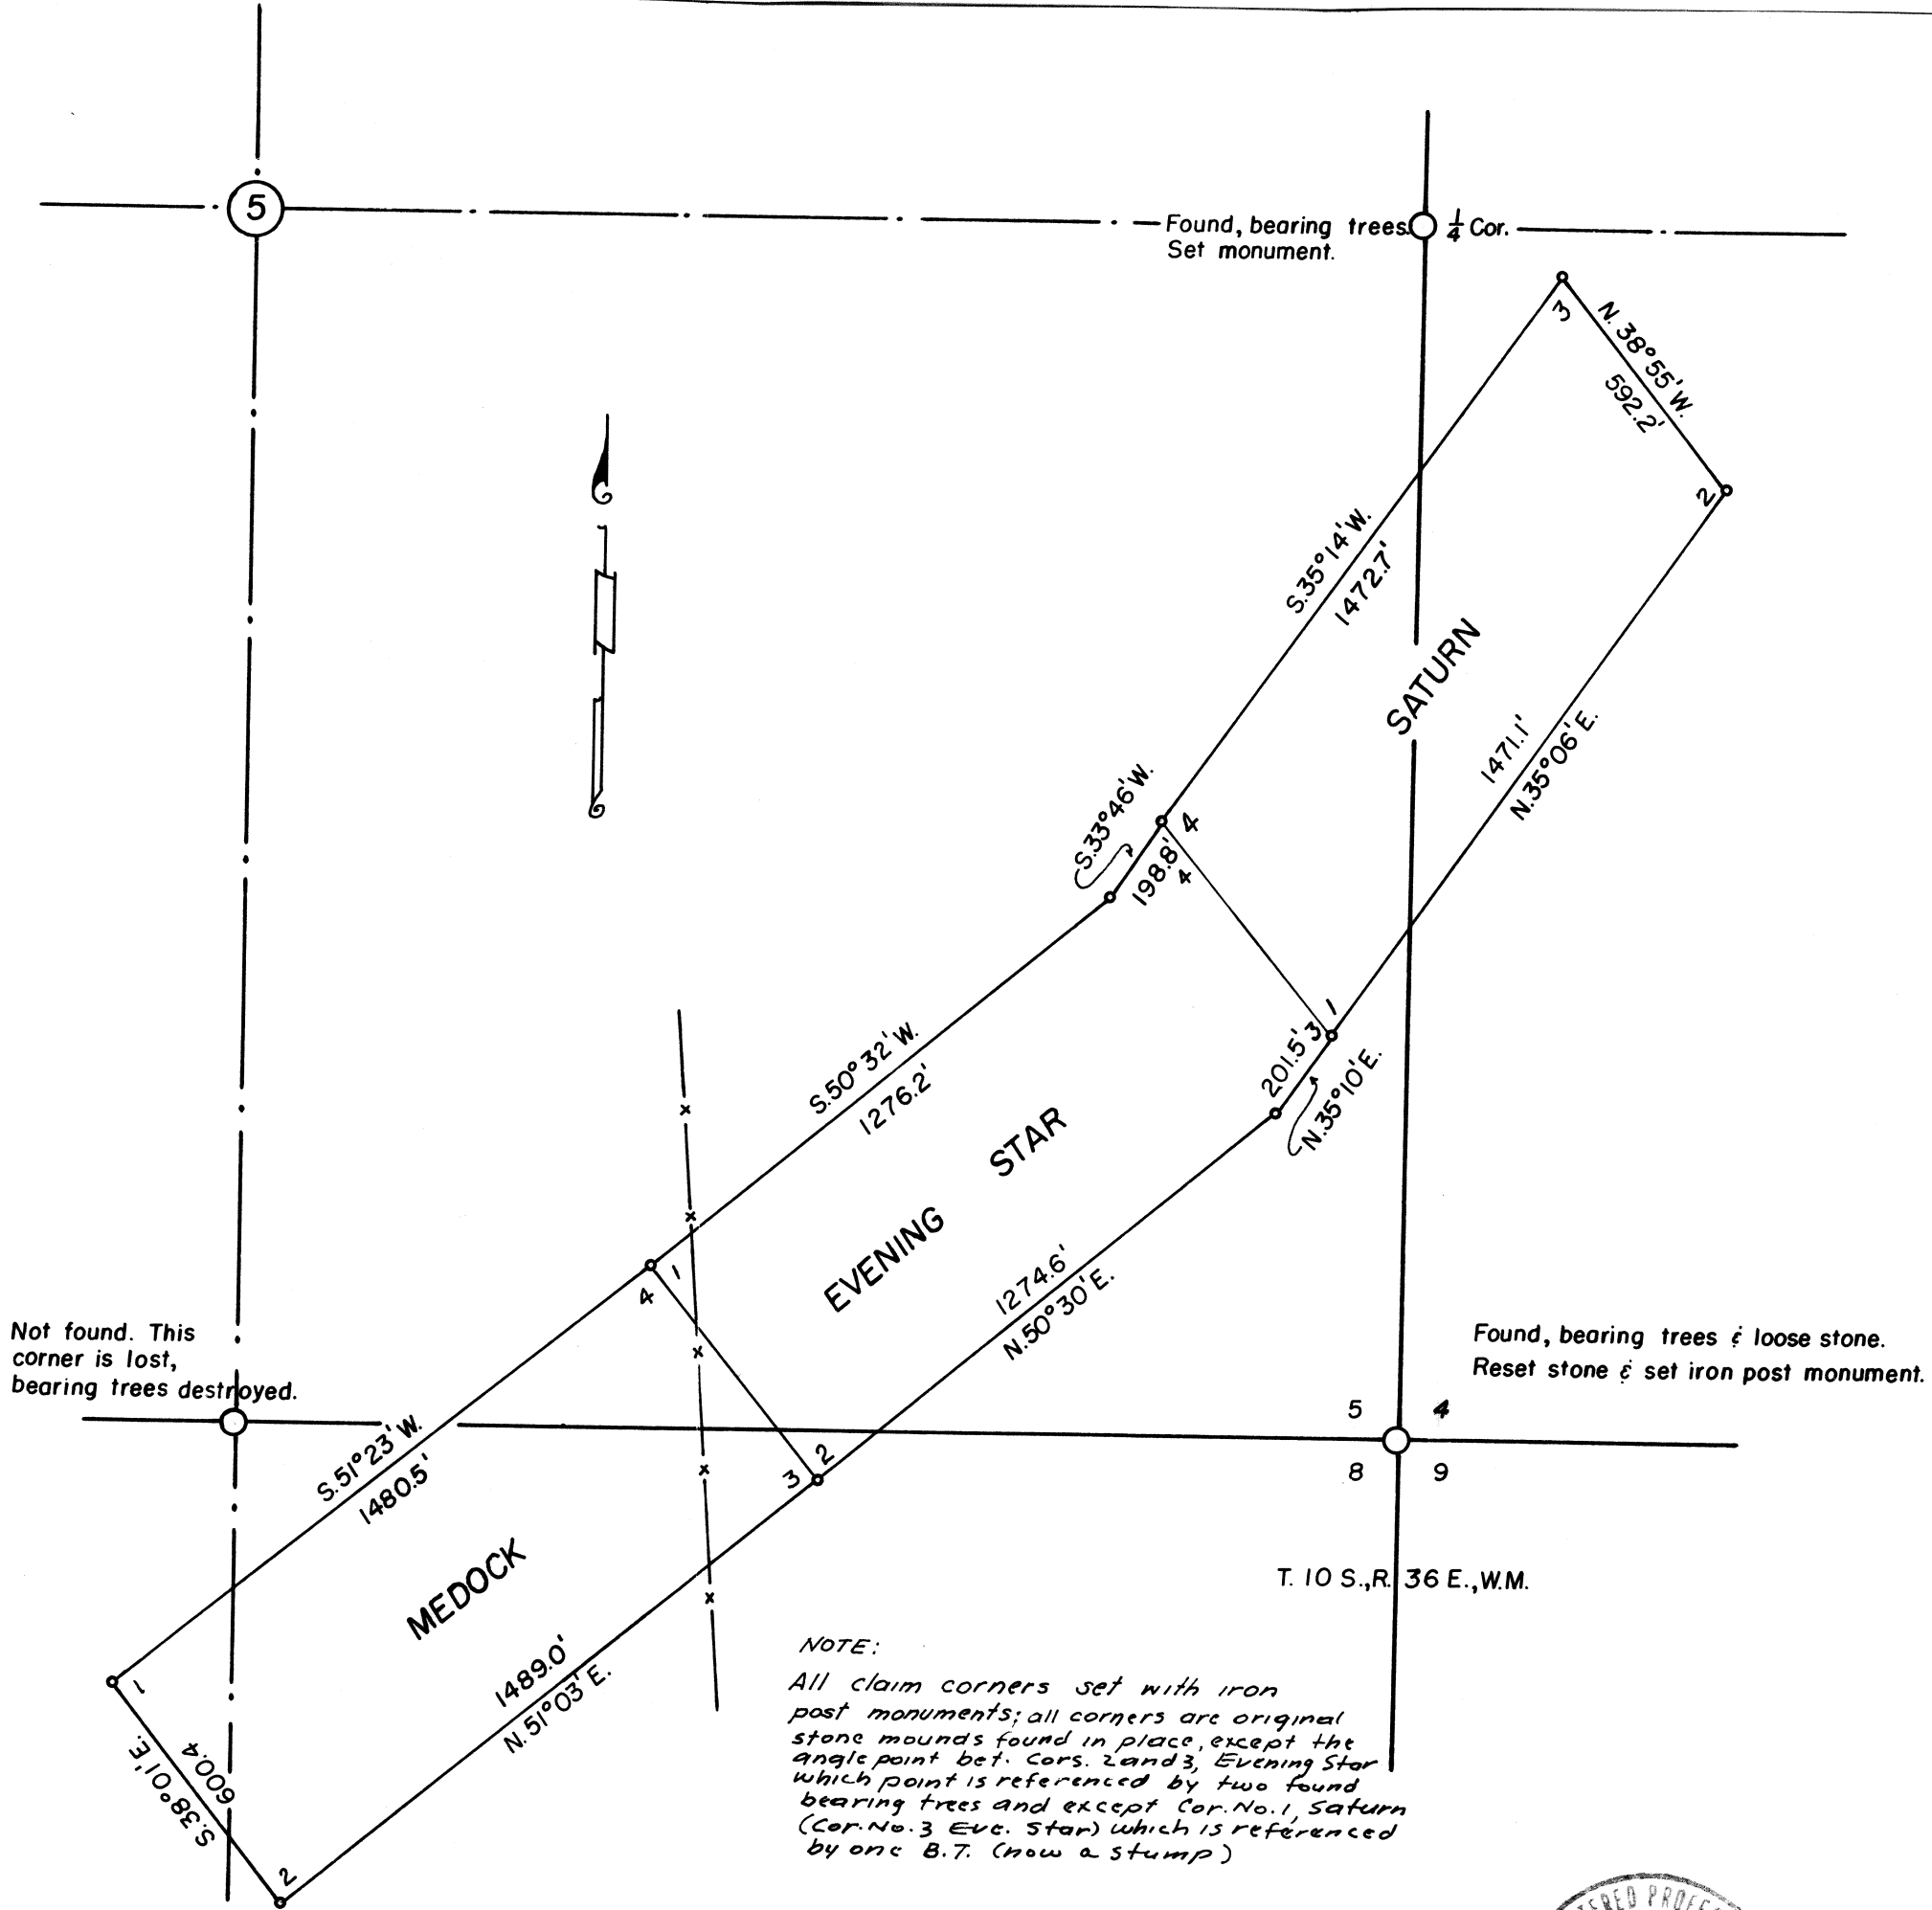

FILED July 28, 1964

BAKER COUNTY SURVEYOR

SURVEY NO. 10-36-1

SURVEY OF MS 225

June-July, 1964

Scale 1" = 400'

