
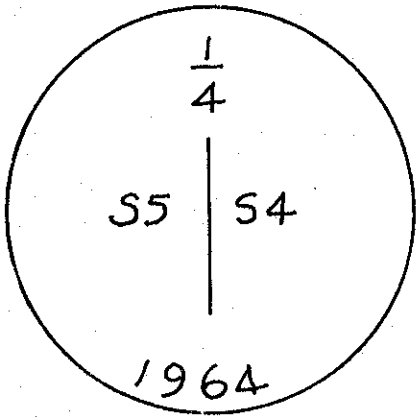


Monuments are $2\frac{1}{4}$ -inch alum.
caps on 1-inch galv. iron
pipes, marked as shown;
all in T. 10S., R. 36E., W.M.,
set in 1964 by J.D. Hanley.

See Survey of MS 225 of
June-July, 1964.

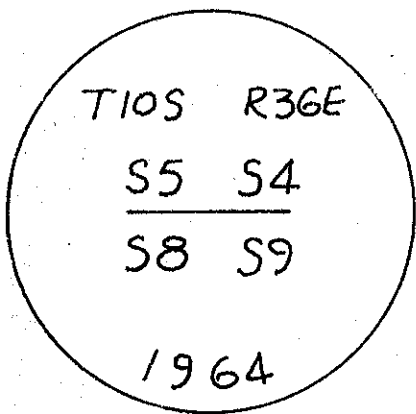

FILED 1-2-65
BAKER COUNTY SURVEYOR
SURVEY NO. 10-36-2