

CERTIFIED RECORD OF LAND CORNER MONUMENTATION

(Reference FSH 5681.65)

History of original corner establishment:

Set a basalt stone 14 x 12 x 8 ins. 10 ins. in the ground for Cor. to Sec's. 1, 6, 7, and 12, marked with 1 notch on North and 5 notches on South edges from which;

A pine 30 ins. in dia. bears N 40 E, 87 lks. dist. marked T 10 S, R 36 E, S 6 BT.

A pine 30 ins. in dia. bears S 55 E, 88 lks. dist. marked T 10 S, R 36 E, S 7 BT.

A pine 48 ins. in dia. bears S 40 W, 98 lks. dist. marked T 10 S, R 35½ E, S 12 BT.

No other trees within limits, I raised mound of stone along side.

Description of corner evidence found:

Found a basalt stone 14 x 12 x 8 ins. 5 ins. in the ground with a mound of stone along side, being the cor. to sec's 1, 6, 7, and 12, marked with 1 notch on North and 5 notches on South faces.

Found a pine 34 ins. in dia. bears N 40 E, 87 lks dist. marked T 10 S, R 36 E, S 6 BT.

Found a pine 30 ins. in dia. dead and lying on ground of which bears S 55 E, 88 lks. approx. with blaze marked T 10 S, R 36 E, S 7 BT.



Found a pine 49 ins. in dia. bears S 40 W, 90 lks. dist. dead and lying on ground deteriorating, blaze faces cor. and marked T 10 S, R 35½ E, S 12 BT.

Description of monument and accessories I established to perpetuate the original location of this corner

Placed more stone in the mound to make mound dimensions of 3 feet in dia. and 1½ feet high.

Placed bearing tree tag on live bearing tree, with the bearing and distance to the sec. cor. scribed on the tag.

Placed a location poster on another tree near the corner with the bearing and distance to the corner scribed on the poster.

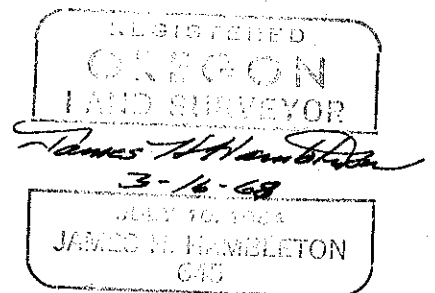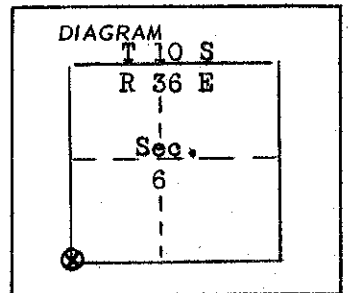

Office of County Surveyor County of Baker
 State of Oregon, I hereby certify that the within instrument was filed in this office
 for record on the 28 day of March, 19 68, at 5 o'clock P.m., (signed)
 _____ by Tom Hanley
 (COUNTY OFFICIAL) (DEPUTY)

SURV. NO. 10-36-3