


CERTIFIED RECORD OF LAND CORNER MONUMENTATION

(Reference FSH 5681.65)

History of original corner establishment:

Set a Basalt Stone marked with 5 notches on E. and 1 notch on W. edges, with a mound of stone placed along side.

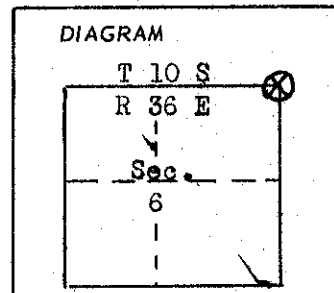

Description of corner evidence found:


Found mound of stone for sec. cor. to sec's. 5, 6, and 31, 32, T 9 and 10 S, R 36 E, no evidence of any stone with notches on any sides.

There were no established bearing trees to be found, though the area contained adequate trees to be used. I found an old corner location poster on a 30 in. pine that had been set, with no reference to the corner on the poster.

Description of monument and accessories I established to perpetuate the original location of this corner

Placed more stone on the mound to increase the dimensions of the mound to 3 feet in diam. and 1 1/2 feet high.

Placed a corner location poster on a tree and scribed on the poster, the bearing and distance to the sec. cor.

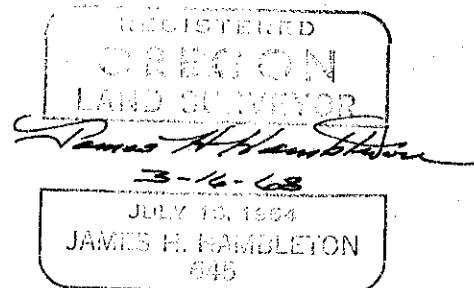

Office of County Surveyor County of Baker
 State of Oregon, I hereby certify that the within instrument was filed in this office
 for record on the 28 day of March, 1968, at 5 o'clock p.m., (signed)
Tom Hamley by Tom Hamley
 (COUNTY OFFICIAL) (DEPUTY)

SURVEY NO. 10-36-4