

CERTIFIED RECORD OF LAND CORNER MONUMENTATION

(Reference FSH 5681.65)

History of original corner establishment:

Set post 3 ft. long, 3 ins. square, 24 ins. in the ground for $\frac{1}{4}$ Sec. Cor. marked $\frac{1}{4}$ S on W face from which;

A pine 10 ins. dia. bears N 30 E, 50 lks. dist. marked $\frac{1}{4}$ S B.T.

A pine 9 ins dia. bears S 80 W, 52 lks. dist. marked $\frac{1}{4}$ S B.T.

DIAGRAM

T 10 S
1/4 cor.
1 | 6
R 35 1/2 E R 36 E
1967
#645

Description of corner evidence found:

Found no evidence of the corner post as it has rotted completely within a 100 year period.

Found pine 20 ins. dia. out out a blaze with the marking $\frac{1}{4}$ S B.T.


Found no other tree in area that would match the description of the other bearing tree.

Description of monument and accessories I established to perpetuate the original location of this corner

By using the only found bearing tree, I measured 50 lks. dist. on a bearing S 30 W from the said tree. At this point I set a 1 inch x 30 inch iron pipe with aluminum cap stamped as shown in the above diagram, I placed a mound of stone about the base of the pipe with the dimensions of 3 feet in dia. and 1 1/2 feet high.

Placed a bearing tree tag on the live bearing tree with the bearing and distance to the corner scribed on the tag.

Placed a corner location poster on another tree and scribed on the poster, the bearing and distance to the $\frac{1}{4}$ sec. cor.

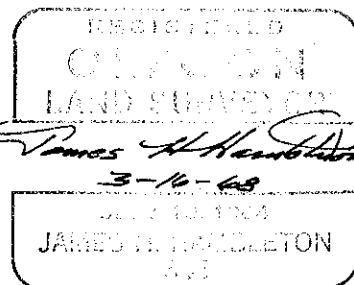

Office of County Surveyor County of Baker
State of Oregon, I hereby certify that the within instrument was filed in this office
for record on the 28 day of March, 1968, at 5 o'clock P.m., (signed)
..... by Tom Stanley
(COUNTY OFFICIAL) (DEPUTY)