

# CERTIFIED RECORD OF LAND CORNER MONUMENTATION


(Reference FSH 5681.65)

**History of original corner establishment:**

Set a sand stone 14 x 10 x 5 ins. 9 ins. in ground for  $\frac{1}{4}$  Sec.  
Cor. marked  $\frac{1}{4}$  on the north face, from which;

A pine 24 ins. dia. bears N 30 E 108 lks dist. marked  $\frac{1}{4}$  S BT.

A pine 24 ins. dia. bears S 10 W 82 lks. dist. marked  $\frac{1}{4}$  S BT.

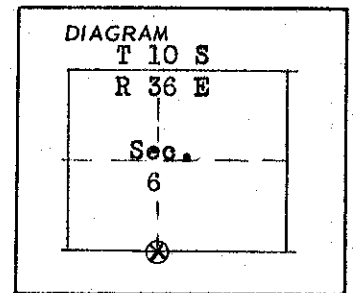

**Description of corner evidence found:**

Found a mound of stone with two wooden posts in the mound being located the prescribed distance from the bearing tree, but there was no stone in the mound that could be identified by having  $\frac{1}{4}$  scribed on the N face.

Found pine 24 ins. dia. bears N 30 E, 108 lks. dist. marked  $\frac{1}{4}$  S BT.


There was no evidence of any other bearing tree for this corner.

**Description of monument and accessories I established to perpetuate the original location of this corner**

Placed more stone in the mound to make mound of dimensions 3 feet in dia. and 1  $\frac{1}{2}$  feet high.

Placed a bearing tree tag on the found bearing tree with the bearing and distance to the  $\frac{1}{4}$  sec. cor. scribed on the tag.

Placed a corner location poster on another tree with the bearing and distance to the  $\frac{1}{4}$  sec. scribed on the poster.

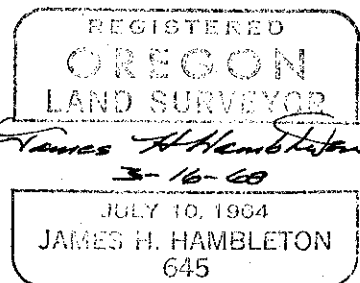

Office of County Surveyor County of Baker  
State of Oregon, I hereby certify that the within instrument was filed in this office  
for record on the 28 day of March, 19 68, at 5 o'clock P.M., (signed)  
\_\_\_\_\_ by Tom Hambleton  
(COUNTY OFFICIAL) (DEPUTY)

SURVEY NO. 10-36-8