

CERTIFIED RECORD OF LAND CORNER MONUMENTATION


(Reference FSH 5681.65)

History of original corner establishment:

Set a post 3 feet long, 3 ins. square, 24 ins in the ground for $\frac{1}{4}$ Sec. Cor., marked $\frac{1}{4}$ S on W. face from which;

A pine 6 ins. diam. bears N 30° E, 20 lks. dist. marked $\frac{1}{4}$ S BT.

A pine 6 ins. diam. bears N 12° W, 74 lks. dist. marked $\frac{1}{4}$ S BT.

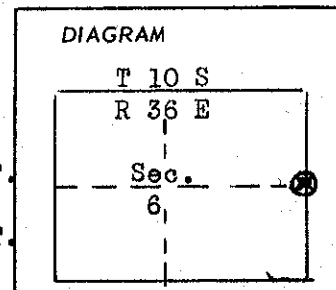

Description of corner evidence found:

Found no evidence of the corner post as it has rotted completely within a 100 year period.


Found pine 14 ins. dia. dead and laying on ground after chopping out a blaze found $\frac{1}{4}$ S BT scribed on tree, being approx 6 in. in diam.

Found no other reference tree or evidence there of, after making an extensive search in the area.

Description of monument and accessories I established to perpetuate the original location of this corner

After determining the original position of the found bearing tree, I then placed a mound of stone 3 feet in diam. and 1 $\frac{1}{2}$ feet high for the $\frac{1}{4}$ Sec. Cor., by measuring S 12° E, 74 lks. dist. from the original position of the bearing tree.

Placed a corner location poster on a tree with the bearing and distance to the $\frac{1}{4}$ sec. cor. scribed on the poster.

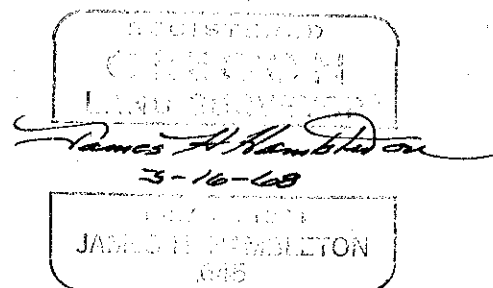

Office of County Surveyor County of Baker
 State of Oregon, I hereby certify that the within instrument was filed in this office
 for record on the 28 day of March, 1968, at 5 o'clock Pm. (signed)
 _____ by Tom H. Ely
 (COUNTY OFFICIAL) (DEPUTY)

SURVEY NO. 10-36-9